

APPROVED REFUSED
THIS DAY OF _____, 20____

DERICK MOORE, MANAGER
DEVELOPMENT REVIEW WEST
PLANNING, INFRASTRUCTURE AND ECONOMIC
DEVELOPMENT DEPARTMENT, CITY OF OTTAWA







STORM MANHOLE SCHEDULE						
LOCATION	INVERT ELEVATIONS (m)				TOP COVER (m)	MANHOLE TYPE
	NORTH	SOUTH	EAST	WEST		
EX. 87.453	87.453	87.453	87.453	87.453	1800#	
MH 1	87.520	87.520	87.520	87.520	101.530	1520X1830
MH 2			98.631	98.716	101.640	1500#
MH 3			98.850	99.400	102.200	1200#
MH 4	97.920	97.920	97.920	97.920	101.550	1520X1830
MH 5	99.710	99.710	99.710	99.710	101.790	1200#
MH 6	98.603	98.750	98.750	98.750	101.910	1520X1830
MH 8	98.360	98.360	98.360	98.360	101.920	1520X1830
CBMH 9	100.070	98.410	98.800	98.800	101.700	1500#
CBMH 10	98.030	98.030	98.030	98.030	101.700	1500#
CBMH 11	98.190	100.090	100.090	100.090	101.700	1200#
MH 14	98.800	98.800	98.800	98.800	102.330	1520X1830
MH 15	99.130	99.130	99.130	99.130	102.140	1200#
MH 16	99.020	99.020	99.020	99.020	103.140	1200#
MH 17	99.020	99.020	99.020	99.020	102.010	1220X1220
CBMH 18	99.770	100.970	100.970	100.970	101.750	1200#
MH 19	99.180	99.180	99.180	99.180	102.400	1200#
MH 20	99.300	99.300	99.300	99.300	102.415	1200#
MH 21				99.230	102.060	1200#
MH 22	98.500	98.750	98.750	98.750	101.750	1520X1830
MH 23	98.260	98.260	98.260	98.260	101.705	1220X1220
CBMH 24			100.016	98.620	101.750	1500#
CBMH 25	98.920	98.920	98.920	98.920	101.600	1200#
MH 26	98.740	98.740	98.740	98.740	101.930	1500#
MH 27	100.070	100.070	100.070	100.070	101.950	1200#
MH 28	100.180	100.180	100.180	100.180	102.080	1200#
CBMH 29	98.617	98.617	100.035	100.035	101.650	1200#
CBMH 30	98.977	98.977	100.050	100.050	101.650	1200#
CBMH 31	98.710	100.310	100.310	100.310	101.900	1200#
CBMH 32	98.600	98.600	98.600	98.600	101.650	1200#
MH 33	EX. 99.342	EX. 99.342	99.492	103.070	101.650	1520X1830
MH 34	100.360	100.282	99.607	99.678	102.98	1800#
CBMH35	100.354	100.510	102.650	102.650	1200#	
CBMH36	100.850	100.466	102.650	102.650	1200#	
BOX MH37	100.475		99.811	99.840	102.890	1520X1830
MH 39	99.96		99.90		101.90	1200#
MH 40	100.22	100.19	100.22	100.22	102.23	1200#
MH 41	100.03		100.06		102.00	1200#
MH 42	99.30	99.90	99.36	102.10	1200#	
MH 63		99.46	99.40	100.13	101.70	1200#
MH 64	99.52		100.17	100.06	101.60	1200#

SANITARY MANHOLE SCHEDULE						
LOCATION	INVERT ELEVATIONS (m)				TOP COVER (m)	MANHOLE TYPE
	NORTH	SOUTH	EAST	WEST		
MH1A	EX. 98.30	EX. 98.30	98.30		102.750	1500#
MH2A			99.020	99.020	103.030	1200#
MH3A			99.250	99.250	101.630	1200#
MH4A			99.250	99.250	101.500	1200#
MH5A			99.250	99.250	101.750	1200#
MH6A	99.710	99.710			101.790	1200#
MH7A	99.780	99.780			101.760	1200#
MH8A	99.940	100.050	100.010	100.010	102.420	1200#
MH9A			100.050	100.300	102.090	1200#
MH10A	100.330				102.430	1200#
MH11A		100.220	100.280	102.360	1200#	
MH12A		100.510	100.510	102.980	1200#	
MH13A		99.216	99.226	102.950	1200#	
MH14A		99.468	99.356	102.900	1200#	
MH15A	99.884			102.920	1200#	
MH16A			99.477	99.487	102.950	1200#
MH17A	EX. 98.466	EX. 98.466	99.066	103.060	1500#	
MH18A	100.01	100.04		102.06	1200#	

* COMPLETE WITH WATER TIGHT FRAME & COVER

STORM CATCHBASIN SCHEDULE						
LOCATION	INVERT ELEVATIONS (m)				TOP COVER (m)	MANHOLE TYPE
	NORTH	SOUTH	EAST	WEST		
TRENCH DRAIN CB	99.65				101.05	
OCB 2			99.25		101.30	
OCB 3			100.70		101.40	
OCB 4			99.87		101.40	
OCB 5			99.22		101.55	
CB 6	100.20			100.30	101.80	
CB 7			100.40		101.80	
CB 8	100.20			100.40	101.70	
CB 9			100.40		101.85	
CB 10	100.20			100.30	101.80	
CB 11			100.40		101.80	
OCB 12	100.25			100.40	101.80	
CB 13	100.25			100.40	102.08	
CB 14	100.25			100.40	102.08	
CB 15	100.25			100.40	102.08	
CB 16	100.25			100.40	102.08	
CB 17	100.25			100.40	102.08	
CB 18	100.25			100.40	101.45	
CB 19	100.25			100.40	101.90	
CB 20	100.25			100.40	102.32	
CB 21	100.25			100.40	102.32	
CB 22	100.25			100.40	101.98	
CB 23	100.25			100.40	101.98	
CB 24	100.25			100.40	101.85	
CB 25	100.25			100.40	102.44	
CB 26	100.25			100.40	102.44	
CB 27	100.25			100.40	101.83	
CB 28	100.25			100.40	101.83	
CB 29	100.25			100.40	101.65	
CB 30	100.25			100.40	101.65	
CB 31	100.25			100.40	101.65	
CB 32	100.25			100.40	101.65	
CB 33	100.25			100.40	101.60	
CB 34	100.25			100.40	101.60	
CB 35	100.25			100.40	101.60	
CB 36	100.25			100.40	101.60	
CB 39	100.25			100.40	101.65	
CB 40	100.25			100.40	101.65	
CB 41	100.25			100.40	101.75	
CB 42	100.25			100.40	101.65	
CB 43	100.25			100.40	101.65	
CB 44	100.25			100.40	101.65	
CB 45	100.25			100.40	101.65	
CB 46	100.60				102.45	
CB 47		100.945			102.45	
CB 48		101.15			102.45	
CB 49		101.25			102.45	
CB 50		101.25			102.45	
RYCB 51		100.50			102.00	
CB 52					100.25	101.80
CB 53					100.25	101.75
CB 54					100.25	101.47
CB 55					100.25	101.45
CB 56					100.25	101.05
TRENCH CB 57					100.25	101.05
CB 58					100.25	102.26
CB 59					100.25	102.26
CB 60	100.35	REUSE EX. CB	100.280	100.01	101.75	
CB 61	99.95				101.35	
CB 62	99.95				101.35	
ECB					101.95	
CB63					100.20	101.60
CB64					100.15	101.55
CB65					100.30	101.75

WATERMAIN SCHEDULE						
STATION	DESCRIPTION	FINISHED GRADE(m)	TOP OF WATERMAIN(m)	AS BUILT WATERMAIN(m)		
				EX. 100.40	EX. 100.40	
A+1100.0	400x300 TEE	EX.102.60	EX.100.40	EX.100.40		
1+111.5	300# V&V	103.02	100.620	100.60		
1+138.68	SERVICE CONNECTION	102.32	99.920	99.920		
1+178.49	SERVICE CONNECTION	101.44	99.040	99.03		
1+187.68	HYDRANT&TEE	101.54	99.87	99.140	98.99	
1+229.57	SERVICE CONNECTION	101.47	99.070	99.02		
1+282.18	HYDRANT&TEE	101.58	99.18	99.00		
1+305.82	300# V&V	101.48	99.080	99.04		
B+1+312.85	300# TEE	101.44	99.150	99.08		
1+316.27	300x200 REDUCER	101.42	99.020	99.11		
1+351.92	HYDRANT&TEE	101.67	99.270	99.21		
1+353.96	45' BEND	101.65	99.000	99.20		
1+359.52	45' BEND	101.66	98.650	98.94		
C+1+374.38	200# V&V	101.90	99.270	99.270		
B+2+100.00	300# TEE	101.44	99.150	99.16		
2+103.00		101.50	98.950	98.96		
2+103.50	VERTICAL BEND	101.51	98.950	98.96		
2+103.85	VERTICAL BEND	101.54	99.300	99.26		
2+110.00	300# V&V	101.60	99.200	99.21		
2+125.00		101.60	99.300	99.28		
2+175.00		102.22	99.820	99.78		
F+2+186.56	300x200# TEE	101.84	99.440	99.440		
F+3+100.00	300x200# TEE	101.84	99.440	99.440		
3+104.69	200# V&V	101.90	99.500	99.48		
3+152.61	HYDRANT & TEE	102.15	99.750	99.76		
G+3+201.33	200# TEE	101.92	99.520	99.58		
H+3+240.69	HYDRANT	102.10	99.700	99.72		
F+4+100.00	300# TEE	101.84	99.440	99.440		
4+101.60	300# V&V	101.82	99.460	99.50		
4+106.00		101.76	99.800	99.42		
4+112.13	300X150# TEE & HYD	101.85	99.600	99.39		
4+114.64	22' BEND	101.87	99.600	99.42		
4+123.75	22' BEND	101.73	99.330	99.35		
4+167.00		101.87	99.900	99.83		
4+207.97	300# V&V	102.25	99.850	99.36		
4+209.30	VERTICAL BEND	102.25	98.300	98.28		
4+209.80	VERTICAL BEND	102.27	98.300	98.300		
I+4+217.11	300# TEE	102.38	98.300	98.300		
I+4+400.00	300# TEE	102.38	98.300	98.300		
4+403.51	300x200 REDUCER	102.38	98.300	98.300		
4+411.41	SERVICE CONNECTION	102.24	98.300	98.36		
4+418.08	VERTICAL BEND	102.23	98.300	98.38		
4+416.58	VERTICAL BEND	102.23	99.830	99.830		
4+437.57	HYDRANT&TEE	102.06	99.660	99.65		
4+466.57		101.83	99.350	99.350		
4+493.33	SERVICE CONNECTION	102.09	99.690	99.68		
4+498.37	45' BEND	102.10	99.700	99.69		
4+499.78	45' BEND	102.05	99.650	99.70		
J+4+503.78	HYDRANT	102.20	99.800	99.800		
K+5+100.00	300# C/W 50# SADDLE	102.38	98.300	98.28		
5+105.00	45' BEND	102.27	98.300	98.300		
5+107.00	45' BEND	102.30	99.900	99.86		
5+137.00	SERVICE CONNECTION	102.56	100.160	100.14		
L+5+154.50	SERVICE CONNECTION	102.48	100.080	100.07		
K+6+100.00	300# C/W 50# SADDLE	102.38	98.300	98.300		
6+100.50	VERTICAL BEND	102.26	98.300	98.300		
6+102.00	VERTICAL BEND	102.26	99.860	99.860		
6+103.50	300# V&V	102.25	99.850	99.86		
6+106.75	SERVICE CONNECTION	102.26	99.860			

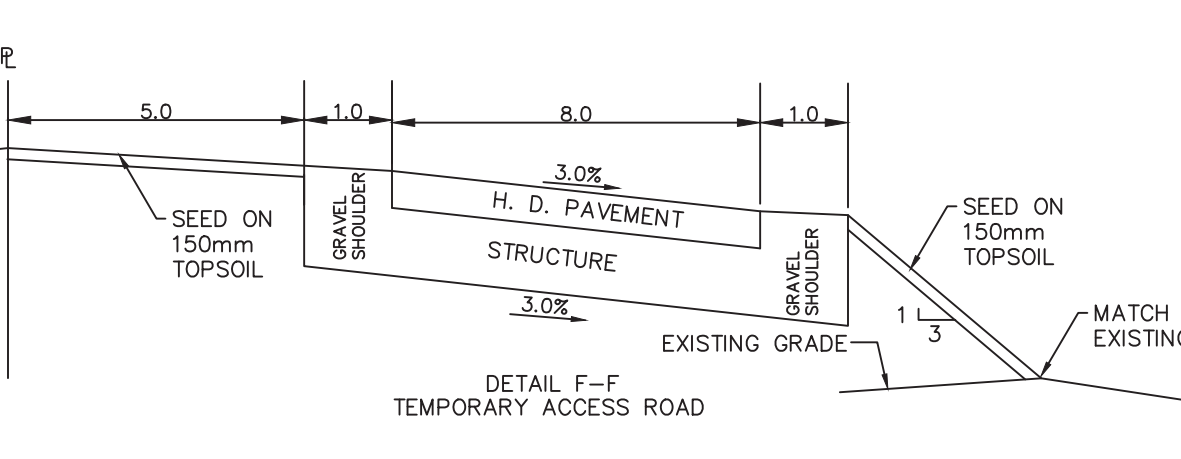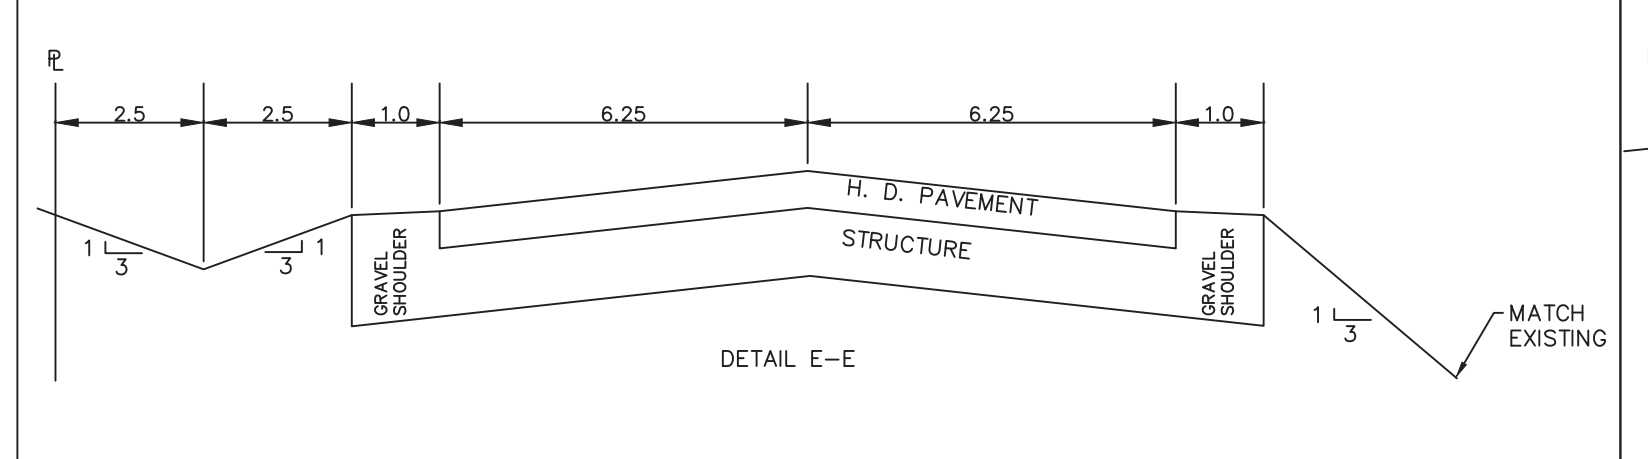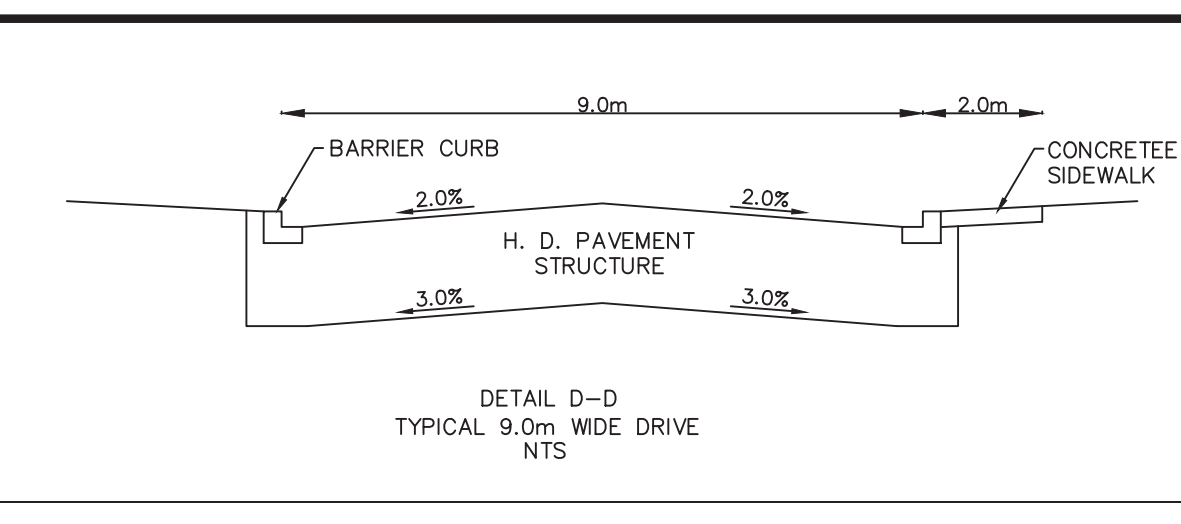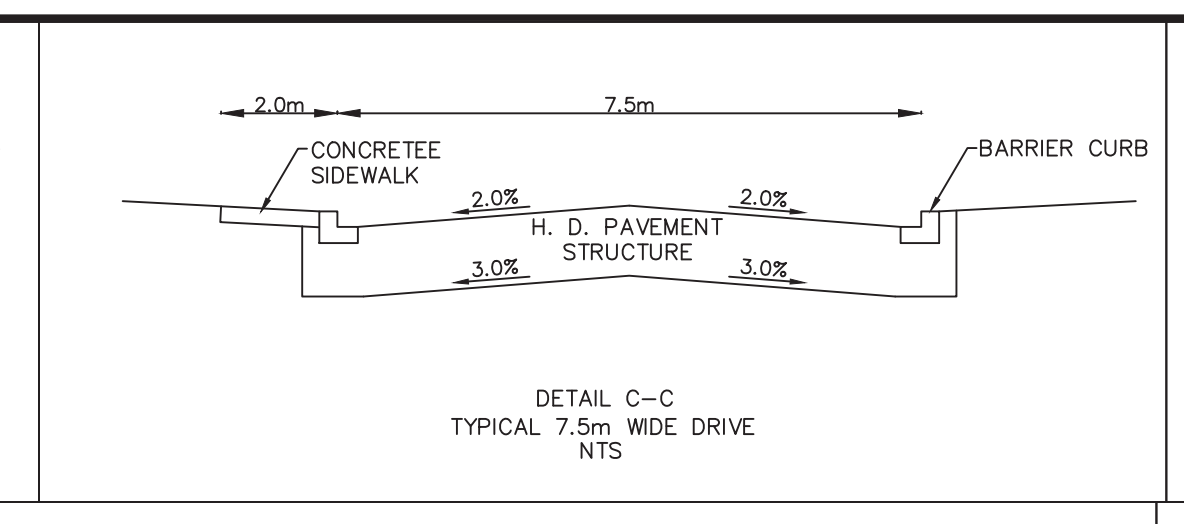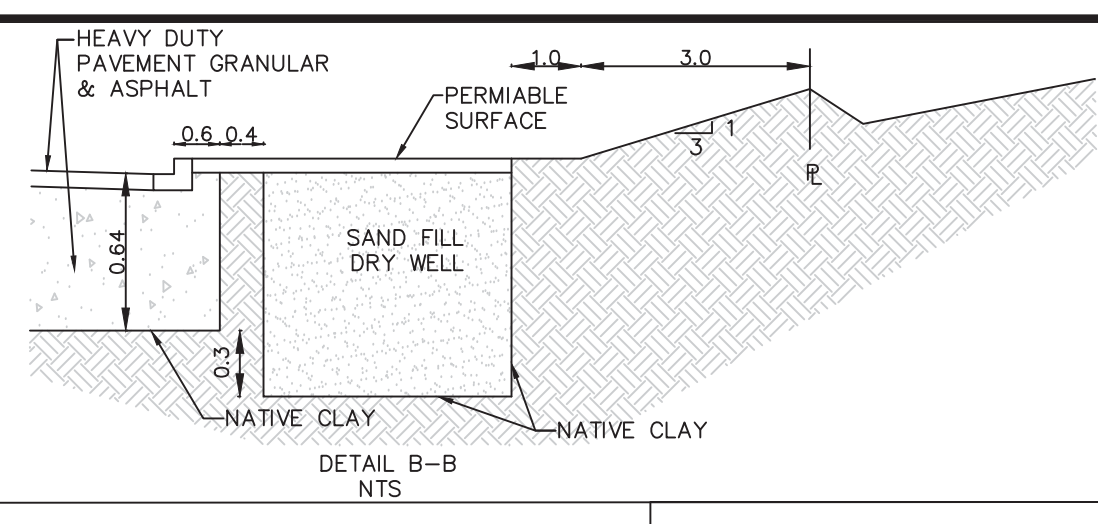
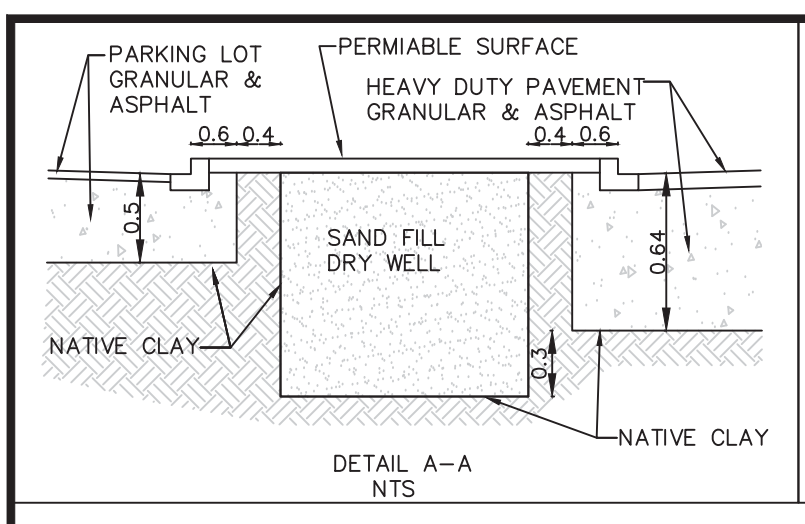


APPROVED REFUSED

THIS DAY OF _____ 20__

DERRICK MOODIE, MANAGER
PLANNING, INFRASTRUCTURE AND ECONOMIC
DEVELOPMENT DEPARTMENT, CITY OF OTTAWA


- LEGEND:**
- PROPOSED GRADES
 - EXISTING SURFACE FLOW DIRECTION
 - PROPOSED SURFACE FLOW DIRECTION
 - PROPOSED CATCHBASIN MANHOLE
 - PROPOSED STREET CATCHBASIN
 - PROPOSED FINISH FLOOR ELEVATION
 - PROPOSED TERRACING
 - PROPOSED RETAINING WALL
 - PROPOSED HYDRANT C/W BOTTOM OF FLANGE
 - PROPOSED BARRIER CURB
 - MAJOR STORM AND FLOW

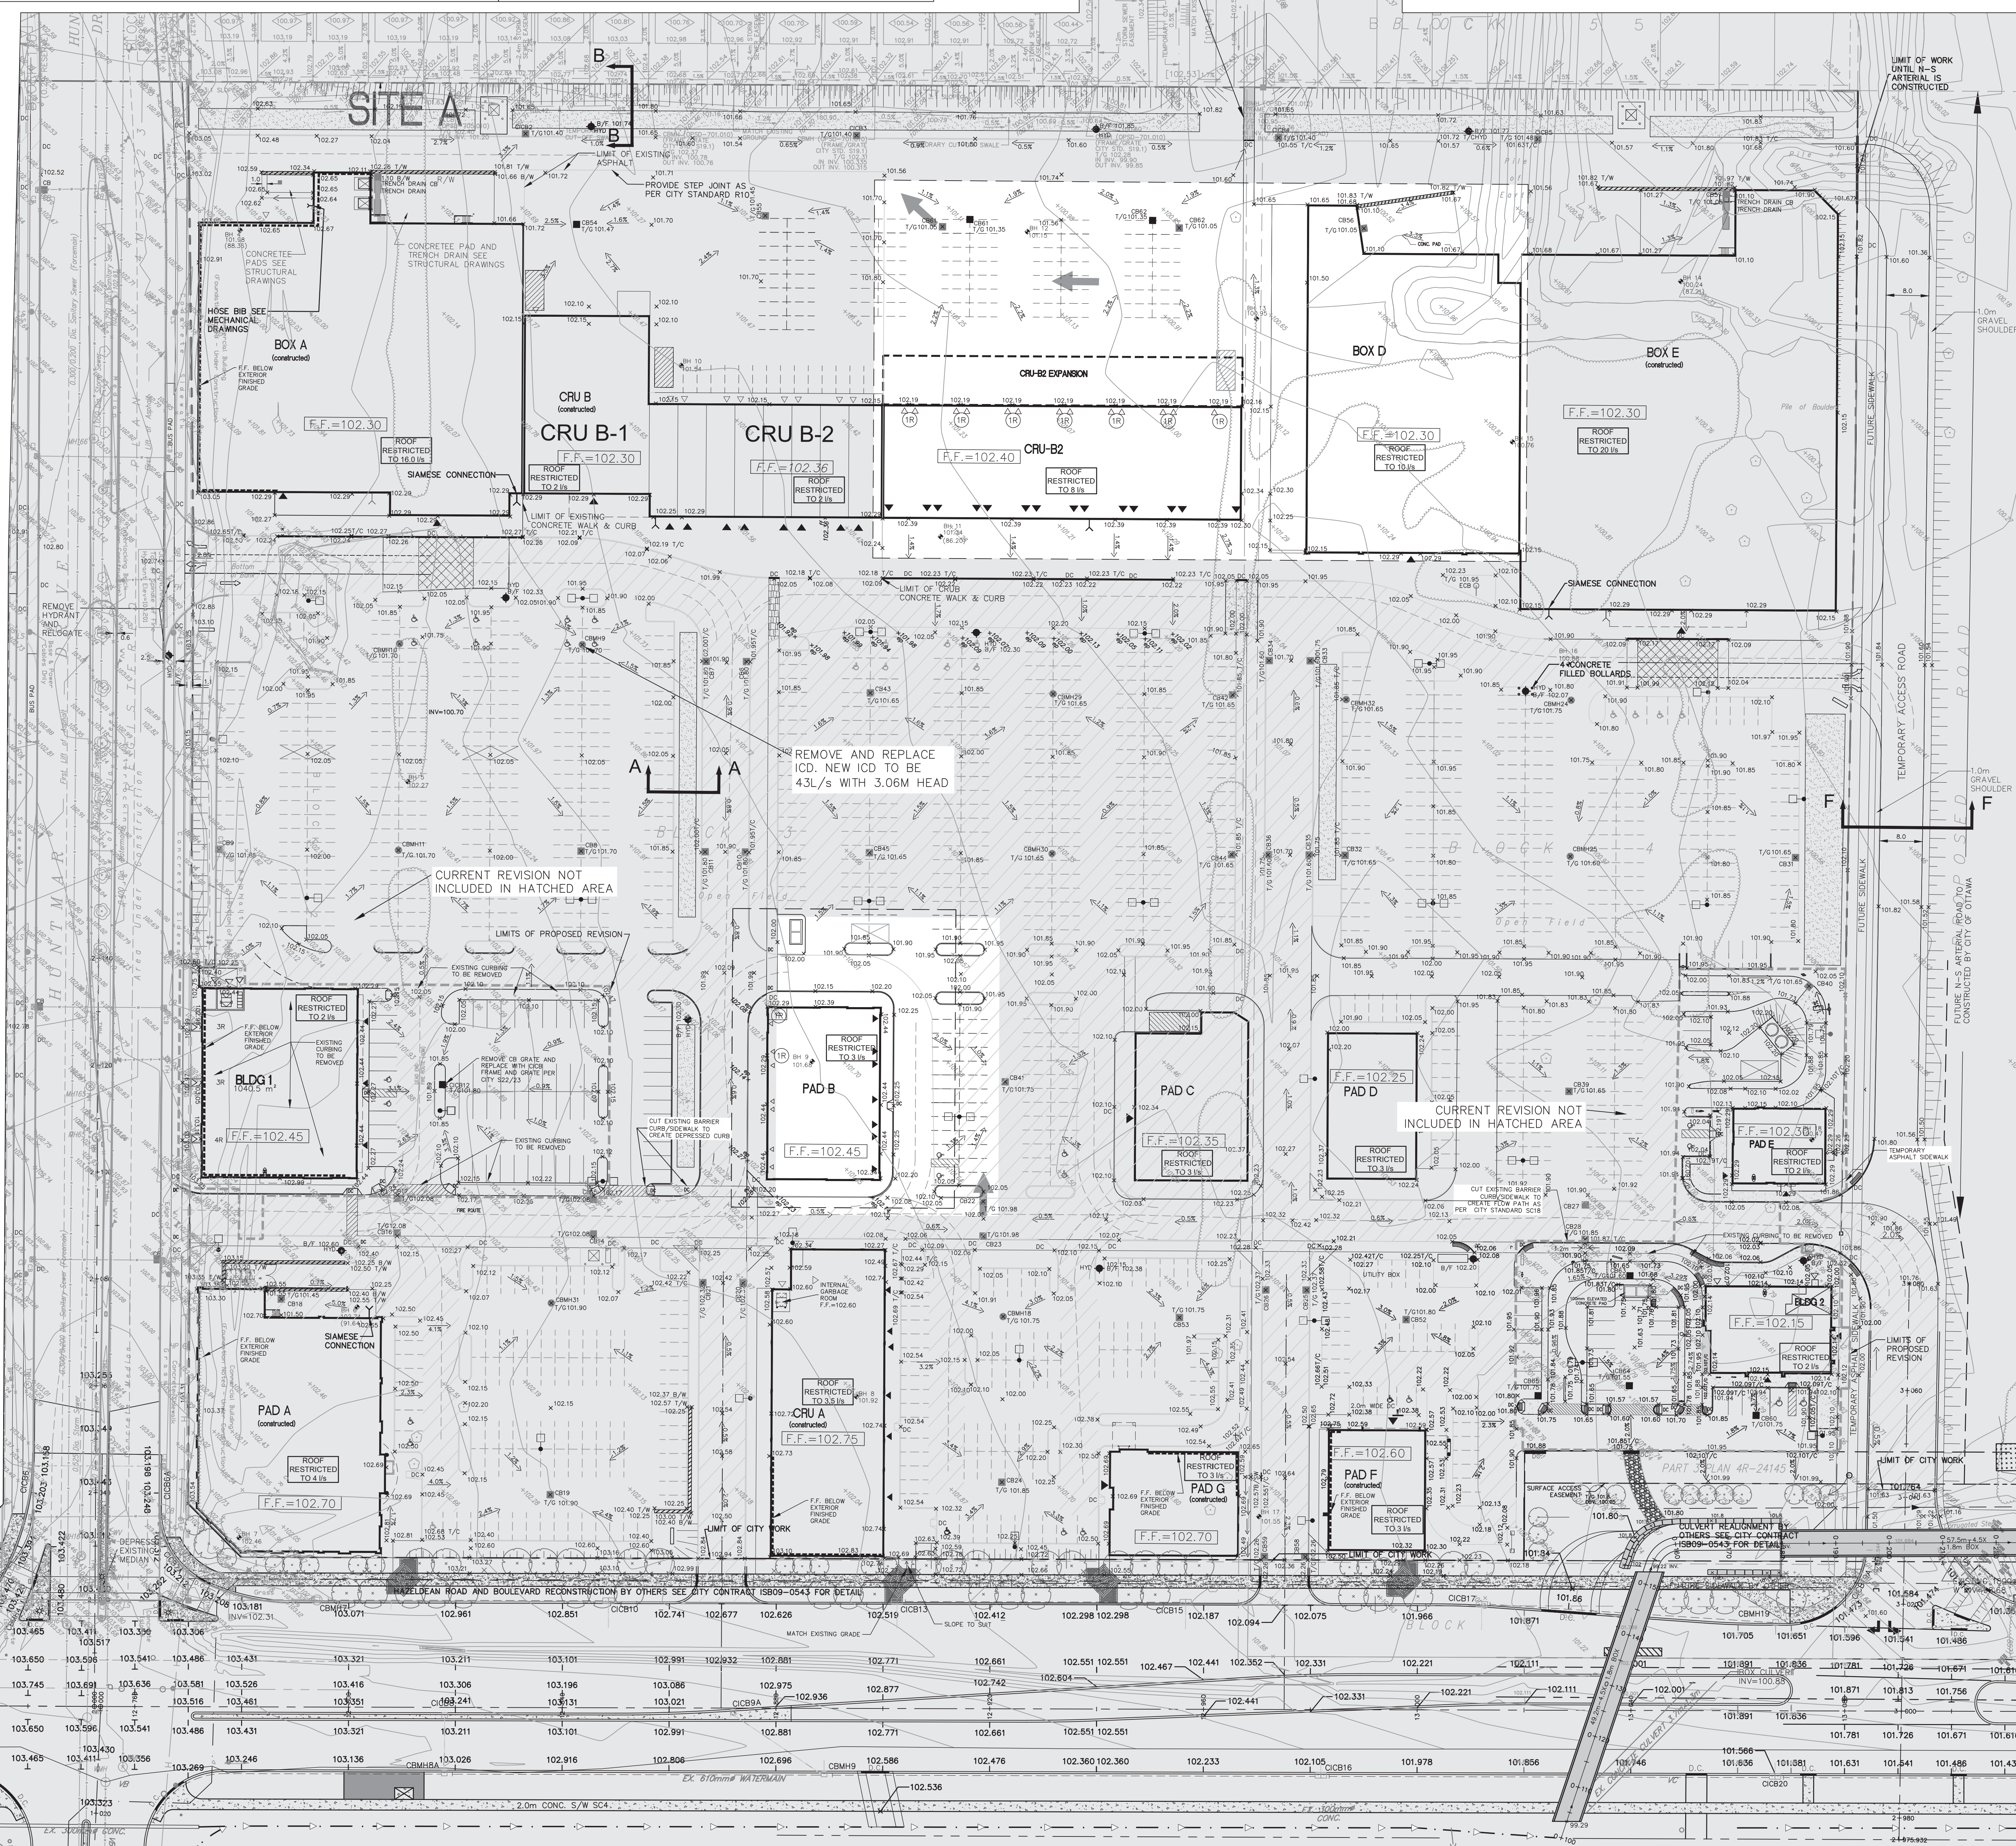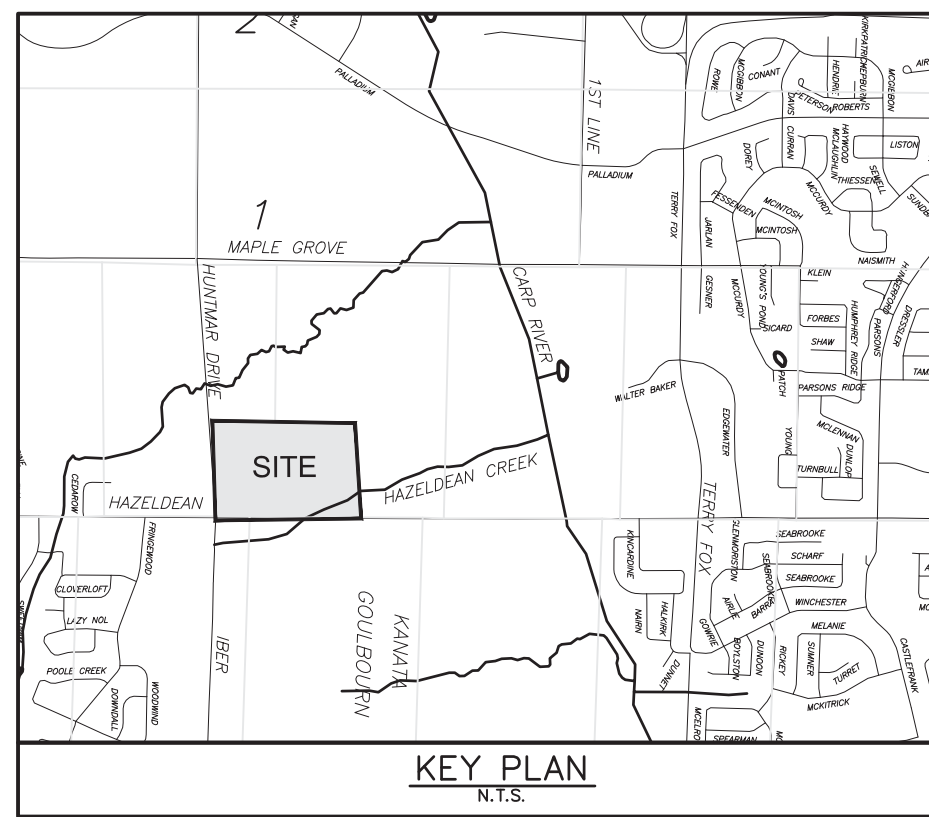


- PAVEMENT STRUCTURE**
- HEAVY DUTY AREAS: 40mm H.B. ASPHALT SUPERPAVE 12.5, 50mm H.B. ASPHALT SUPERPAVE 19.0, 150mm GRANULAR A, 400mm GRAN B TYPE II
 - CAR PARK AREAS: 50mm H.B. ASPHALT SUPERPAVE 12.5, 150mm GRANULAR A, 300mm GRAN B TYPE II
 - CONCRETE PAD
 - INFILTRATION DRY WELL
 - BORE HOLE LOCATION AND ELEVATION: SEE GEOTECHNICAL REPORT FOR DETAILS
 - CONCRETE SIDEWALK
 - AS-BUILT PICK UP

26	REVISED SPA CRU B-3, PAD B, BOX E	DOY	19-08-29
25	REVISED REAR DOOR GRADES PER ARCHITECT	DOY	18-06-10
24	ISSUED FOR CONSTRUCTION BLDG 2	DOY	18-04-06
23	ISSUED FOR TENDER	DOY	18-01-15
22	REVISED AS PER CITY COMMENTS	DOY	17-11-23
21	ISSUED FOR SPA	DOY	17-10-08
20	REVISED AS PER SITE PLAN	DOY	17-07-07
19	REVISED AS PER CITY COMMENTS	DOY	17-07-07
18	REVISED BLD 2 & PAD E	DOY	17-02-23
17	REVISED AS PER CITY COMMENTS	DOY	17-02-14
16	REVISED AS PER CITY COMMENTS	DOY	16-08-05
15	SPA BLDG 1 & 2	DOY	16-03-07
14	REVISED BLDG 1 & 2	DOY	16-01-21
13	REVISED AS PER SITE PLAN	DOY	14-11-03
12	SPA	DOY	14-09-09
11	REVISED AS PER SITE PLAN	DOY	14-08-08
10	REVISED AS PER CITY COMMENTS	DOY	14-07-31
9	REVISED DOLLAR & CRUB	DOY	14-06-03
8	ISSUED FOR PAD F TENDER	DOY	13-02-14
7	REVISED FOR PAD F	DOY	12-11-16
6	REVISED FOR PAD F	DOY	12-08-01
5	REVISED SPRINKLER ROOM	DOY	12-03-09
4	BOX E AND PAD E	DOY	12-02-22
3	REVISED FOR BOX E	DOY	12-01-28
2	REVISED SITE PLAN PH1 & PH2	DOY	11-11-24
1	ISSUED FOR APPROVAL	DOY	11-10-27
No.	REVISIONS	By	Date

NORTH AMERICAN DEVELOPMENT GROUP

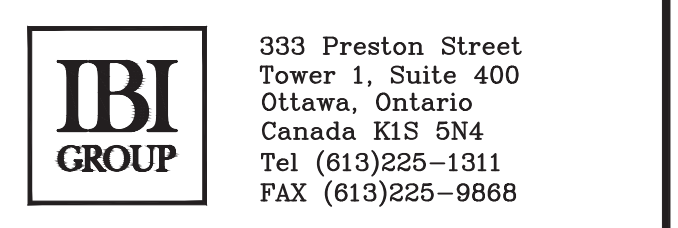

Project Title
5707 HAZELDEAN ROAD
OTTAWA, ONT.

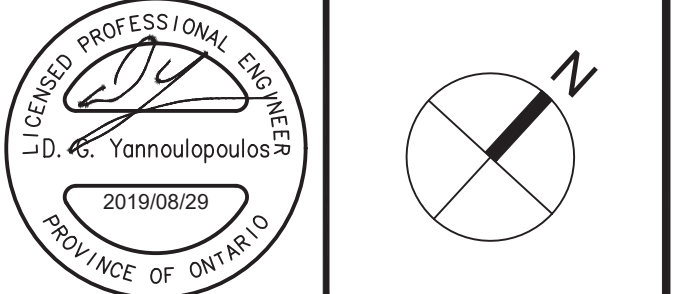


Drawing Title
GRADING PLAN
PHASE 1 & 2

Scale: 1:500


Design	D.G.Y.	Date	OCTOBER 2011
Drawn	E.H.	Checked	D.G.Y.
Project No.	10113	Drawing No.	C-202

D07-12-16-0032

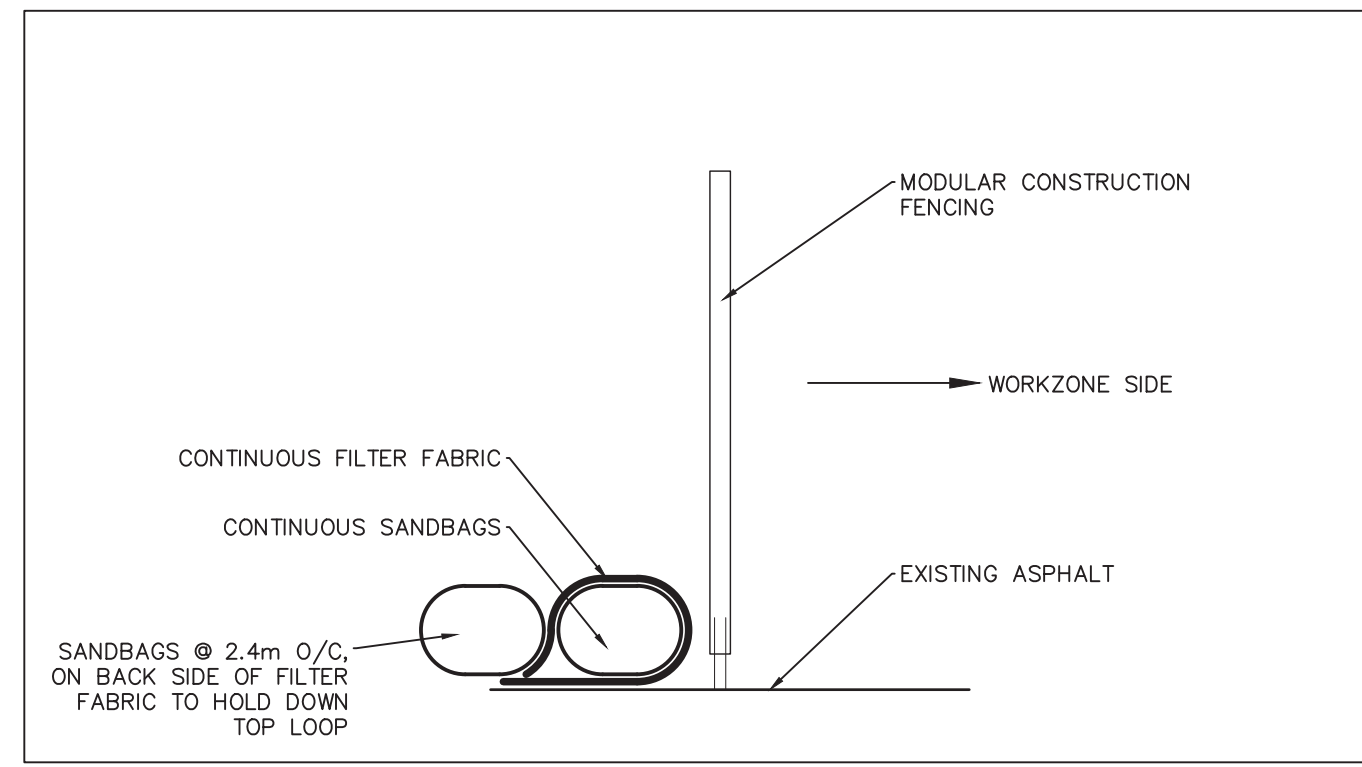

CUSTOM SILT FENCE DETAIL FOR SITE PERIMETER LOCATION AS REQUIRED


APPROVED REFUSED
 THIS DAY OF _____, 20____
 DERRICK MOODIE, MANAGER
 DEVELOPMENT REVIEW WEST
 PLANNING, INFRASTRUCTURE AND ECONOMIC
 DEVELOPMENT DEPARTMENT, CITY OF OTTAWA

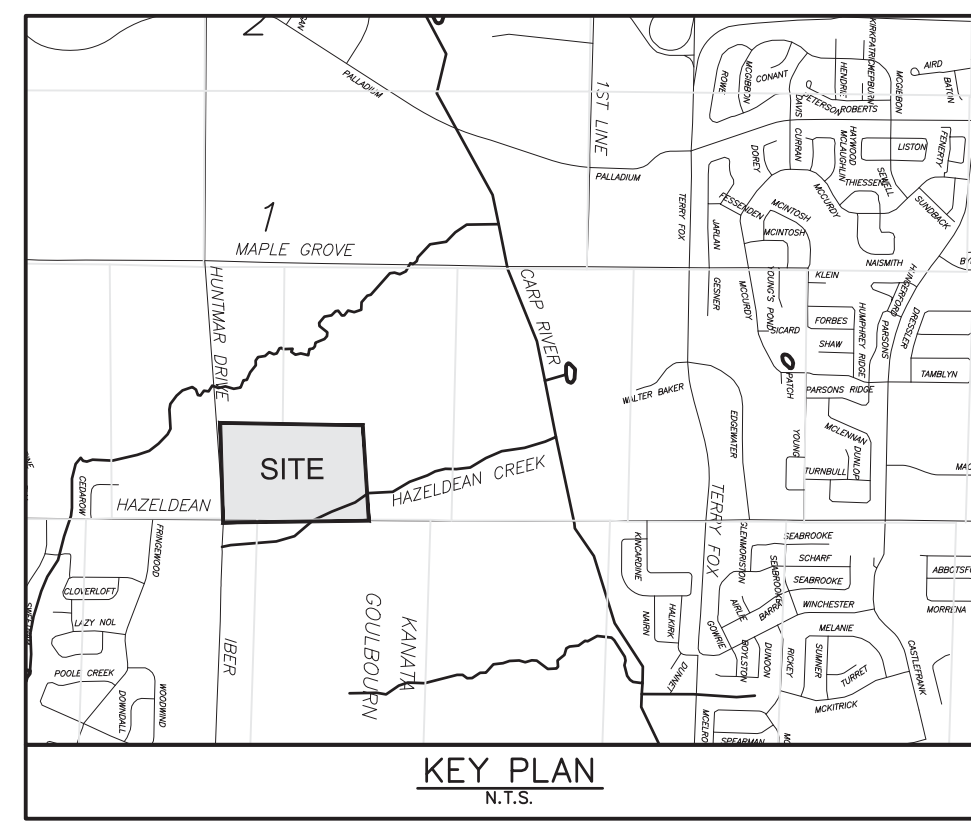

- LEGEND**
- LIGHT DUTY SILT FENCE AS PER OPSD 219.110
 - LIGHT DUTY STRAW BALE BARRIER AS PER OPSD 219.100
 - SILT BAG OR APPROVED EQUAL IN EXISTING CCB OR CB
 - PERIMETER CONSTRUCTION FENCING C/W CONTINUOUS SEDIMENT CONTROL CONSISTING OF SANDBAGS WRAPPED IN FILTER FABRIC

SEDIMENT AND EROSION CONTROL NOTES:

- 6.1 CONTRACTOR TO IMPLEMENT EROSION AND SEDIMENT CONTROL MEASURES AS IDENTIFIED IN THE EROSION AND SEDIMENT CONTROL PLAN TO THE SATISFACTION OF THE CITY OF OTTAWA. PRIOR TO UNDERTAKING ANY SITE ALTERATIONS (FILLING, GRADING, REMOVAL OF VEGETATION, ETC.), DURING ALL PHASES OF THE SITE PREPARATION AND CONSTRUCTION THE MEASURES ARE TO BE MAINTAINED TO THE SATISFACTION OF THE ENGINEER AND CITY OF OTTAWA IN ACCORDANCE WITH THE BEST MANAGEMENT PRACTICES FOR EROSION AND SEDIMENT CONTROL. SHOULD ANY ADDITIONAL MEASURES BE REQUIRED TO ADDRESS FIELD CONDITIONS THEY SHALL BE INSTALLED AS DIRECTED BY THE ENGINEER OR THE CITY OF OTTAWA. THE CONTRACTOR ACKNOWLEDGES THAT FAILURE TO IMPLEMENT APPROPRIATE EROSION AND SEDIMENT CONTROL MEASURES MAY BE SUBJECT TO PENALTIES IMPOSED BY ANY APPLICABLE REGULATORY AGENCY.
- 6.2 ANY GROUND WATER PUMPING IS LIMITED TO 10 000/L AND SHALL BE DISCHARGED IN TO AN APPROVED FILTER MECHANISM PRIOR TO RELEASE TO THE ENVIRONMENT.
- 6.3 SEEPAGE BARRIERS WILL BE CONSTRUCTED IN ANY TEMPORARY DRAINAGE DITCH.
- 6.4 FILLER CLOTHS WILL BE PLACED ON OPEN INFRASTRUCTURES SUCH AS MANHOLE AND CATCH BASIN UNTIL STRUCTURES ARE COMMISSIONED AND PUT IN USE.

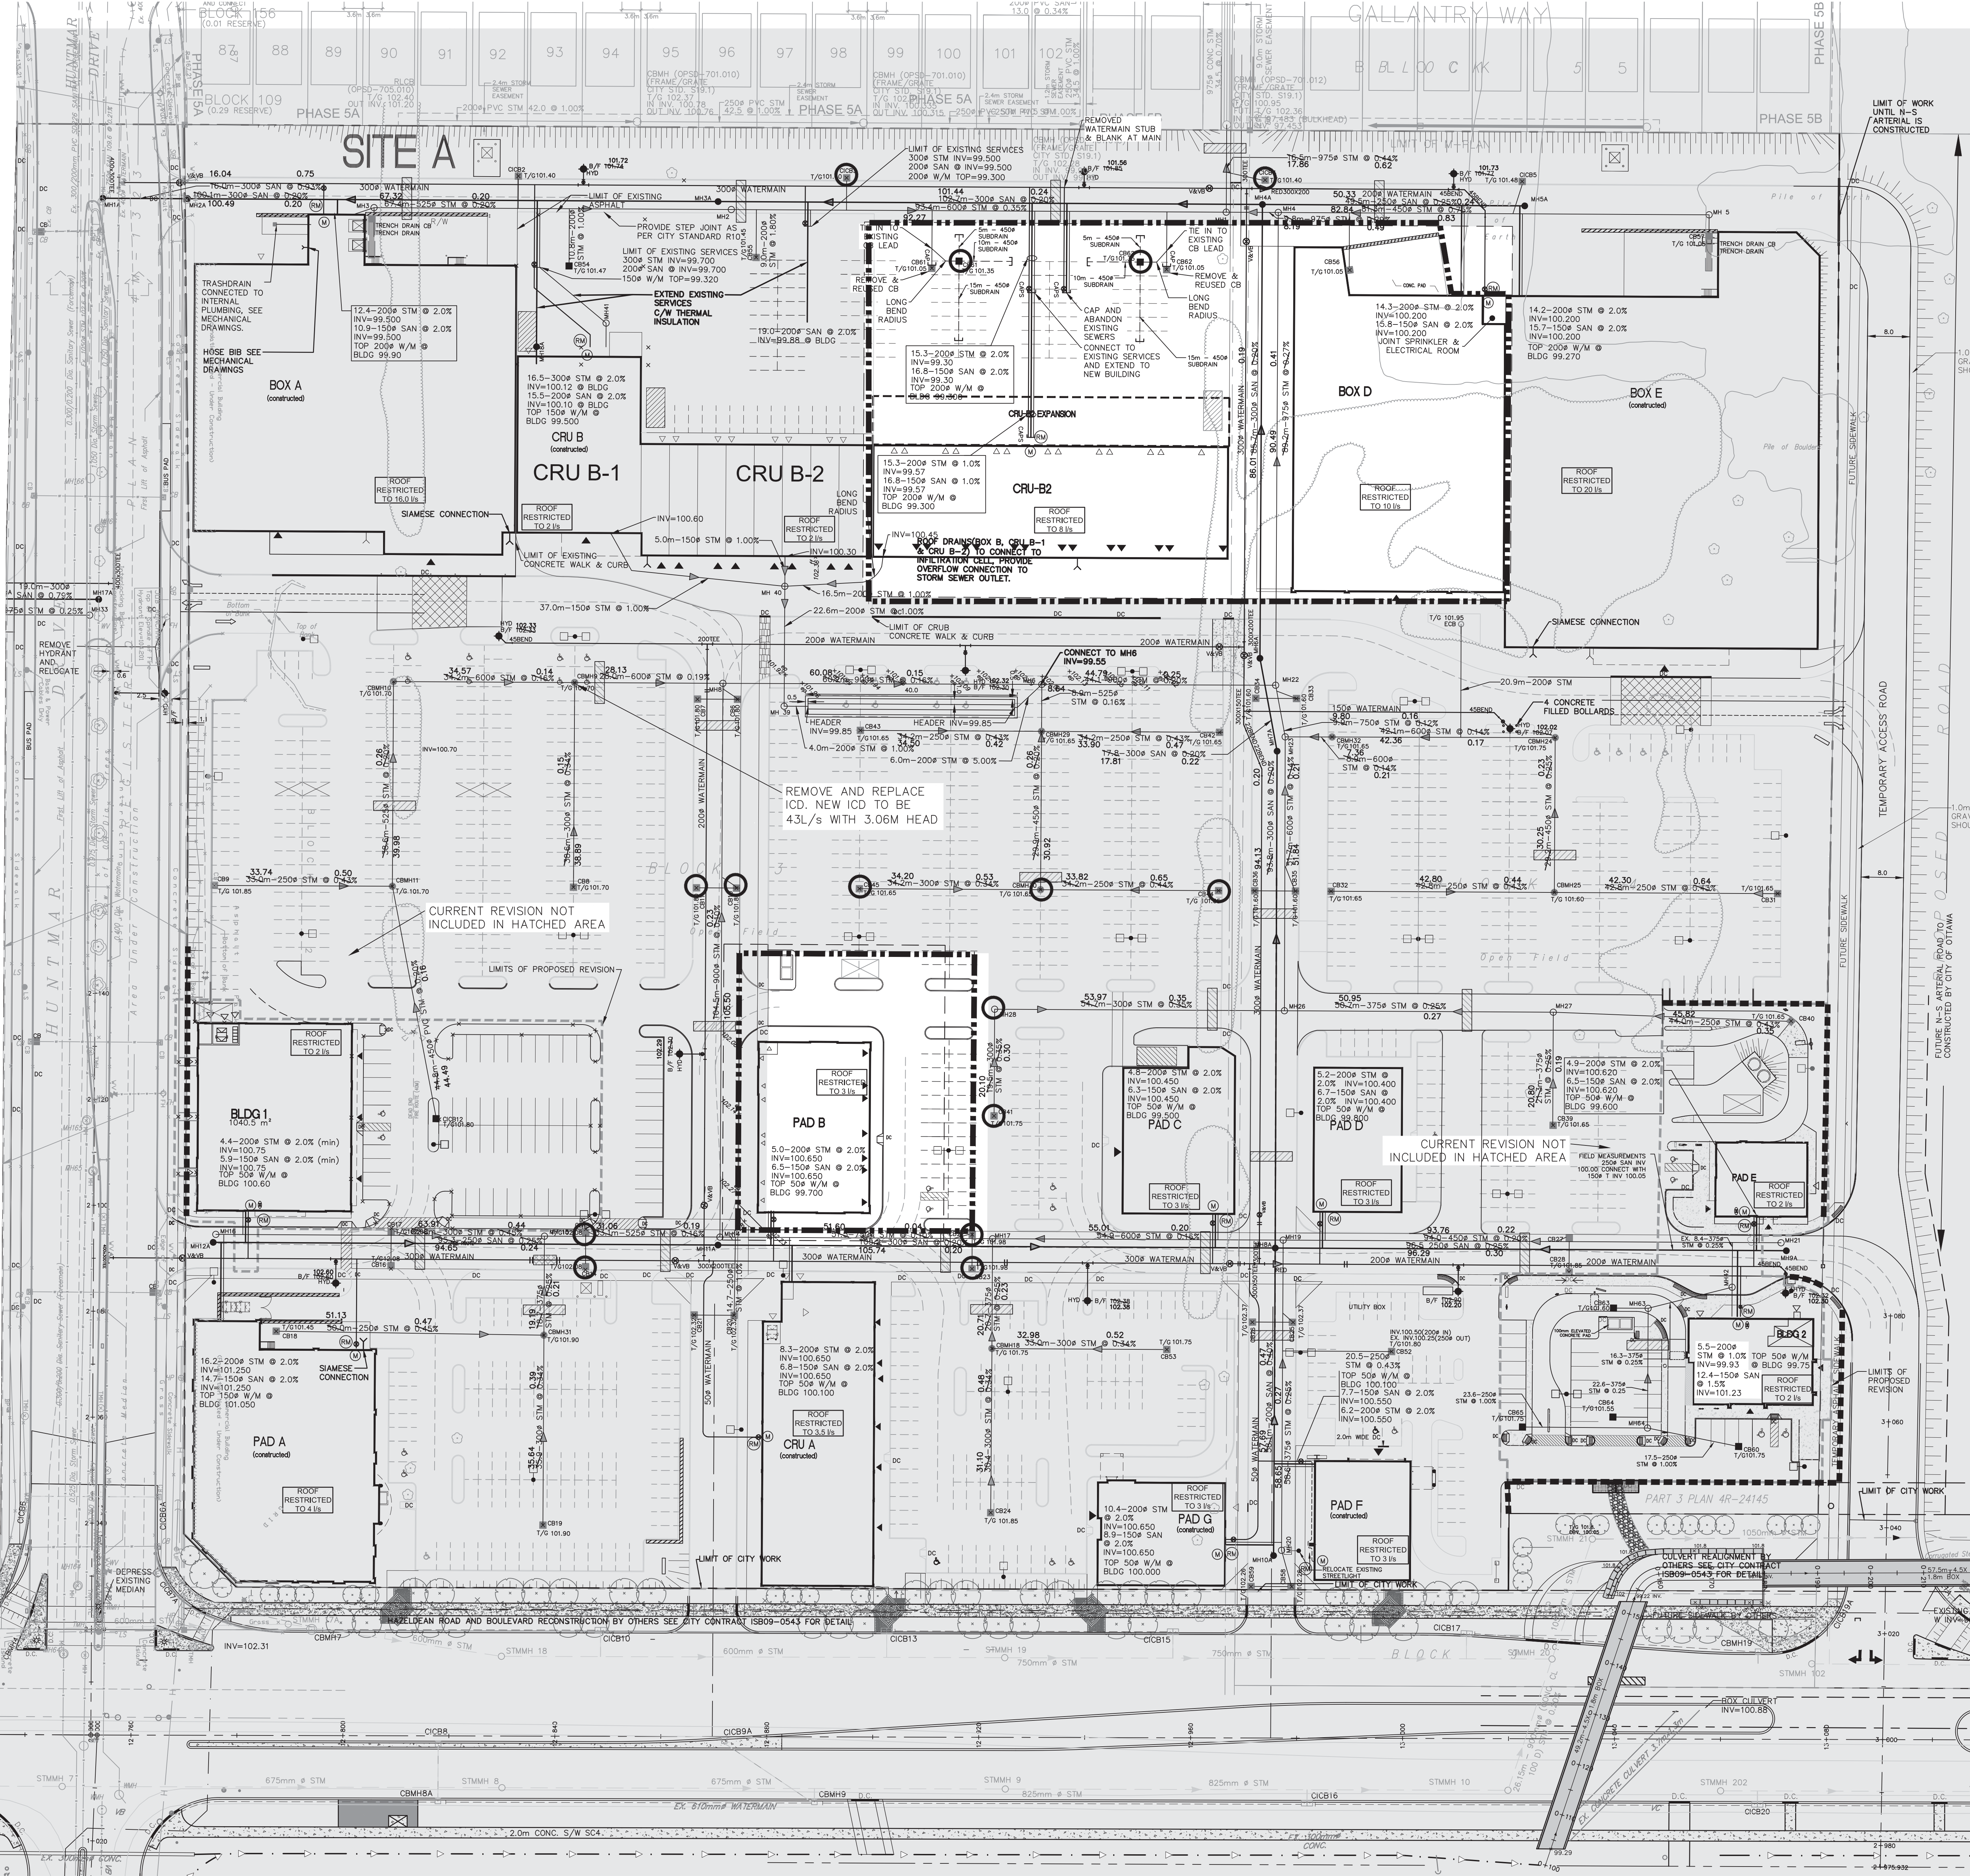


No.	REVISIONS	By	Date
19	REVISED SPA CRU B-3, PAD B, PAD C FOR CONSTRUCTION	DOY	18.08.09
18	ISSUED FOR CONSTRUCTION	DOY	18.04.08
17	ISSUED FOR TENDER	DOY	18.01.15
16	REVISED AS PER CITY COMMENTS	DOY	17.11.23
15	ISSUED FOR SPA	DOY	17.11.02
14	REVISED AS PER SITE PLAN	DOY	17.07.07
13	REVISED AS PER CITY COMMENTS	DOY	17.06.23
12	REVISED BLD 2 & PAD E	DOY	17.02.14
11	REVISED AS PER CITY COMMENTS	DOY	16.08.02
10	SPA BLDG 2 & 2	DOY	16.03.07
9	REVISED AS PER SITE PLAN	DOY	14.11.03
8	SPA	DOY	14.09.09
7	REVISED AS PER SITE PLAN	DOY	14.08.08
6	REVISED AS PER CITY COMMENTS	DOY	14.07.31
5	REVISED DOLLAR & CRUB	DOY	14.06.03
4	REVISED FOR PAD F	DOY	12.11.16
3	REVISED SPRINKLER ROOM	DOY	12.03.09
2	REVISED PER CITY COMMENTS AND PAD E	DOY	12.02.22
1	ISSUED FOR REVIEW	DOY	11.04.19

NORTH AMERICAN DEVELOPMENT GROUP

IBI GROUP
 333 Preston Street
 Tower 1, Suite 400
 Ottawa, Ontario
 Canada K1S 5M4
 Tel: (613)225-1311
 FAX: (613)225-9868

Project Title
5707 HAZELDEAN ROAD
 OTTAWA, ONT.

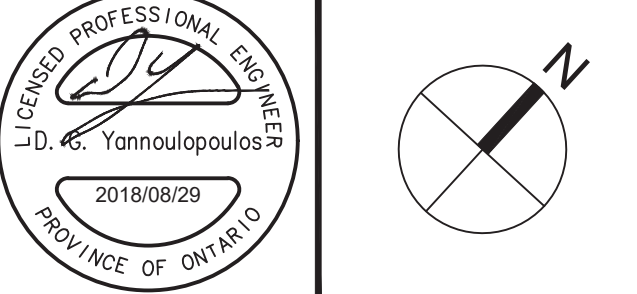

Drawing Title
SEDIMENT AND EROSION CONTROL PLAN
PHASE 1 & 2

Scale
 1:500

Design
 D.G.Y. Date
 OCTOBER 2008

Drawn
 L.R. Checked
 D.G.Y.

Project No.
 10113 Drawing No.
 C-920

D07-12-16-0002