


Notes:

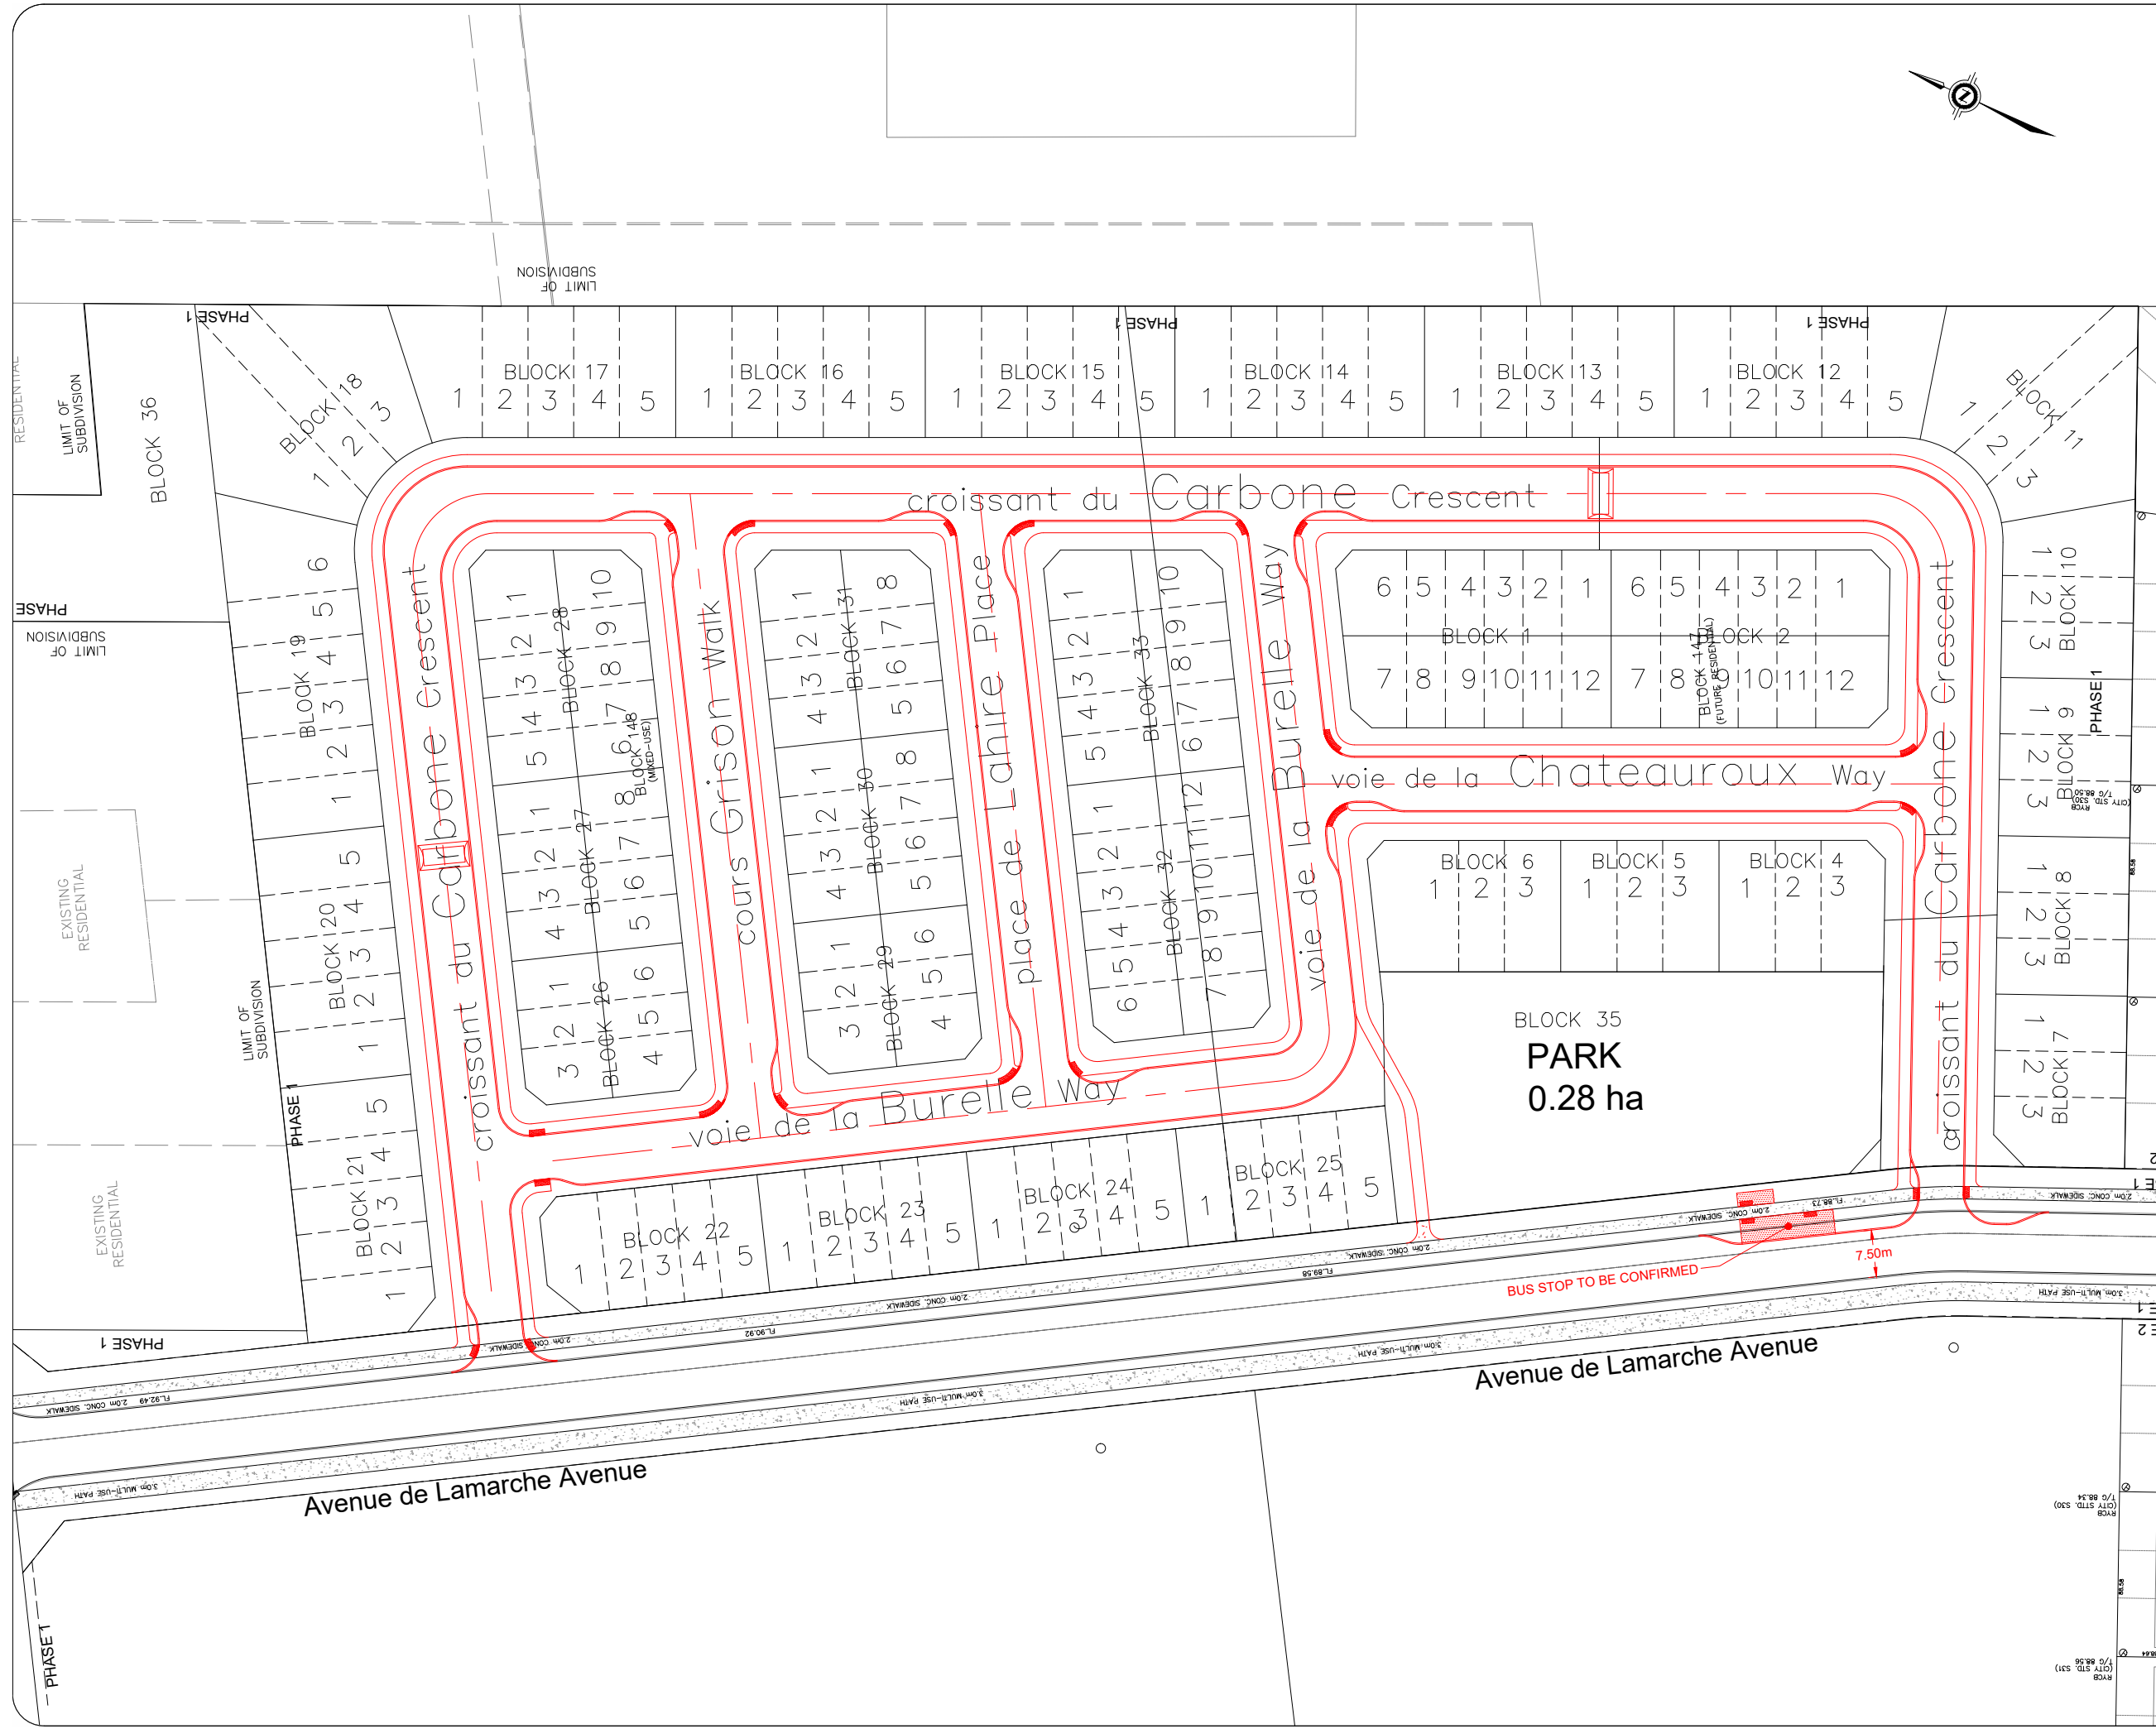

REV:	DESCRIPTION:	BY:	DATE:
04	Updated Site Plan	BB	2022-12-09
03	Updated Site Plan	BB	2022-07-27
02	Updated Site Plan	BB	2022-07-19
01	Issued for Review	BB	2022-04-12

STATUS:



CGH Transportation
6 Plaza Court
Ottawa, ON
K2H 7W1
(343) 999-9117

CLIENT: Caivan (Orleans Village 2) Ltd
2934 Baseline Road, Suite 302h
Ottawa, ON
K2H 1B2

ARCHITECT:

SITE: 245-275 Lamarche Ave

TITLE: Geometric Road Design Redline

SCALE AT A3: NTS	DATE: 2022-12-09	DRAWN: BB	CHECKED: AL
PROJECT NO: 2022-023	DRAWING NO: 001	REVISION: 04	