


SCHEDULE OF LAND USE		
LAND USE	BLOCK(S)	AREA (Sq. m)
SINGLES (DETACHED)	1 TO 7, (BOTH INCLUSIVE), 20, 21, 24, 25, 26, 27, 28, 30, 31, 32,1000	215,112.5
TOWNHOME	8 TO 11, (BOTH INCLUSIVE), 22, 23, 28, 29, 34, 35, 38, 39, 42, 43, 46, 47, 48, 49, 54, 55, 58, 59, 62, 63, 66, 67, 68, 69, 74, 75, 78, 79, 82, 83, 86, 87, 90, 91, 94, 95, 98, 99, 102, 103, 106, 107, 108, 109, 114, 115, 118, 119, 122, 123, 124, 125, 126, 127, 128, 129, 132, 133, 134,1000	54,578.7
BACK-TO-BACK TOWNHOME	12 TO 14, (BOTH INCLUSIVE), AND 16	10,524.5
REAR LANE TOWNHOME	15, 100, 101, 102, 103, 106, 107, 108 AND 109	26,421.2
WALKWAYS	17, 77, 104, 105, 111, 112, 113, 129 AND 132	1,510.5
OPEN SPACE	119 AND 130	3,413.8
BUS LANE	18 AND 116	12,894.2
FUTURE DEVELOPMENT	120	8,233.9
PARK	19, 117, 122 AND 123	44,118.1
NATURAL HERITAGE SYSTEM	124, 125 AND 126	56,283.3
JOCK RIVER OPEN SPACE	127 AND 128	236,996.6
STREET WIDENING	110 AND 118	5,989.5
STREETS	'1' TO '39', (BOTH INCLUSIVE)	174,229.7
LANES	'1' TO '5', (BOTH INCLUSIVE)	7,345.1
TOTAL:		857,651.6

REVISIONS TO APPROVED DRAFT PLAN APPLICATION
 NOTES:
 THE UNDERLYING MONOCHROME PLAN IS THE APPROVED AND SIGNED VERSION.
 THE OVERLAPPING REDLINE IS THE PROPOSED REVISION.


SUBJECT TO THE CONDITIONS, IF ANY, SET FORTH IN OUR LETTER DATED... THIS DRAFT PLAN IS APPROVED BY THE CITY OF OTTAWA UNDER SECTION 51(17) OF THE PLANNING ACT THIS... DAY OF... 2022.

LILY XU, MCR, RPP, MANAGER DEVELOPMENT REVIEW SOUTH PLANNING, REAL ESTATE AND ECONOMIC DEVELOPMENT DEPARTMENT, CITY OF OTTAWA

ADDITIONAL INFORMATION AS REQUIRED UNDER SECTION 51(17) OF THE PLANNING ACT R.S.O. 2001
 (X) - AS SHOWN ON THIS DRAFT AND KEY PLAN
 (O) - LAND TO BE USED IN ACCORDANCE WITH THE SCHEDULE OF LAND USE
 (H) - FULL MUNICIPAL SERVICES
 (S) - OFFSHORE MARINE DEPOSITS OF CLAY, SILT, CLAY AND SILT, BEDROCK
 OTTAWA FORMATION, LIMESTONE

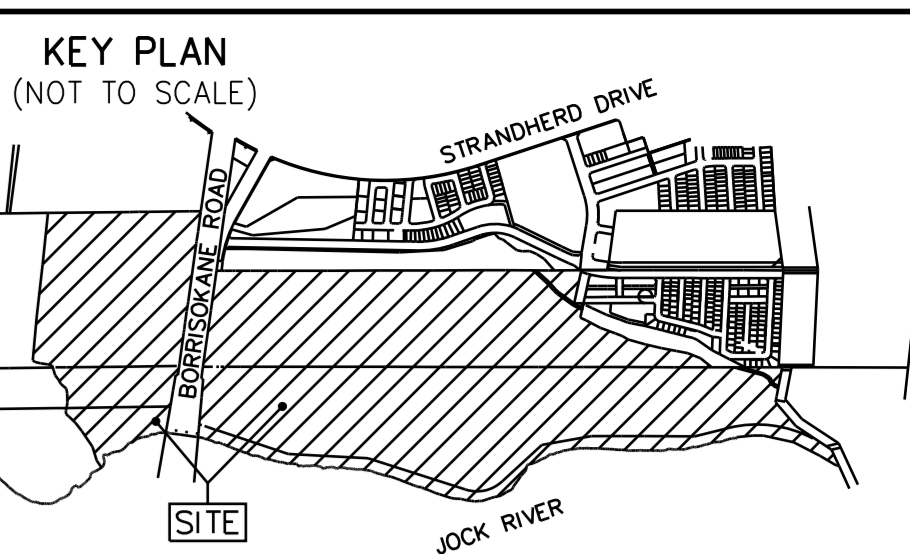

DRAFT PLAN OF SUBDIVISION
 PART OF LOTS 13 AND 14
 CONCESSION 3 (RIDEAU FRONT)
 PART OF LOTS 13 AND 14
 CONCESSION 4 (RIDEAU FRONT)
 GEOGRAPHIC TOWNSHIP OF NEPEAN
 CITY OF OTTAWA
 SCALE 1:1500
 J.D. BARNES LIMITED
 © COPYRIGHT 2022
 DISTANCES AND/OR COORDINATES SHOWN ON THIS PLAN ARE IN METRIC UNITS AND CAN BE CONVERTED TO FEET BY DIVIDING BY 0.3048

 

LINWORK COMPILED FROM REGISTERED PLAN 4M-XXXX (STANTEC - GLENVIEW)

LINWORK COMPILED FROM REGISTERED PLAN 4M-1667

LINWORK COMPILED FROM PLAN 5R-3970

OWNER'S CERTIFICATE
 I HEREBY CERTIFY THAT THE BOUNDARIES OF THE LAND TO BE SUBDIVIDED ARE CORRECTLY SHOWN.

SURVEYOR'S CERTIFICATE
 I HEREBY CERTIFY THAT THE BOUNDARIES OF THE LAND TO BE SUBDIVIDED ARE CORRECTLY SHOWN.

FOR REVIEW
 DATE: _____
 CM FOX
 ONTARIO LAND SURVEYOR

J.D. BARNES LIMITED
 LAND INFORMATION SPECIALISTS
 1000 SHEPPARD AVENUE EAST, SUITE 100, SCARBOROUGH, ONTARIO M1S 1T5
 T: (416) 751-7244 F: (416) 294-8619 www.jdbarnes.com