

ALL ELEVATIONS ON THIS PLAN ARE GEODETIC

REVISIONS

No.	DESCRIPTION	DATE	BY
0	ISSUED FOR REVIEW	NOV 03/06	TP

CLIENT: DYMION CAPITAL  
360 HUNT CLUB RD., UNIT 105  
OTTAWA, ON K1V 1C1  
P: 913.247.0888


PROJECT: INNES ROAD SELF STORAGE  
2015 LANTHIER DRIVE, OTTAWA, ON

DESIGNED TP  
DRAWN dmw  
CHECKED TP

CONSULTING ENGINEERS OF ONTARIO  
McINTOSH PERRY  
115 Watson Rd., P.O. Box 40, Carp, ON, K0A 1L0  
Tel: (613) 836-2164 Fax: (613) 836-3742

DATE: OCT 16, 2006 SCALE: 1:300 metric PROJECT No.: P06-005 OMB No.: C1.0

REFU  
Direct Construction  
SEP 26 2008

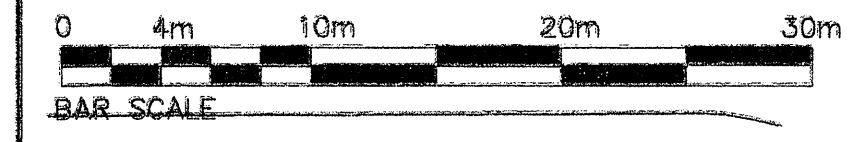

Direct As-Built  
OCT 20 2008