

APPROVED REFUSED

THIS DAY OF _____ 20__


DERRICK MOODIE, MANAGER
DEVELOPMENT REVIEW WEST
PLANNING, INFRASTRUCTURE AND ECONOMIC
DEVELOPMENT DEPARTMENT, CITY OF OTTAWA

APPROVED REFUSED

THIS DAY OF _____ 20__

DERRICK MOODIE, MANAGER
DEVELOPMENT REVIEW WEST
PLANNING, INFRASTRUCTURE AND ECONOMIC
DEVELOPMENT DEPARTMENT, CITY OF OTTAWA

- LEGEND:**
- 102.30 PROPOSED GRADES
 - EXISTING SURFACE FLOW DIRECTION
 - PROPOSED CATCHBASIN MANHOLE
 - PROPOSED STREET CATCHBASIN
 - F.F.=102.30 PROPOSED FINISH FLOOR ELEVATION
 - PROPOSED RETAINING WALL
 - PROPOSED TERRACING
 - PROPOSED HYDRANT C/W BOTTOM OF FLANGE
 - PROPOSED BARRIER CURB
 - MAJOR STORM AND FLOW
- PAVEMENT STRUCTURE**
- HEAVY DUTY AREAS
40mm H.B. ASPHALT SUPERPAVE 12.5
50mm H.B. ASPHALT SUPERPAVE 10.0
150mm GRANULAR A
400mm GRAN B TYPE II
 - CAR PARK AREAS
50mm H.B. ASPHALT SUPERPAVE 12.5
150mm GRANULAR A
300mm GRAN B TYPE II
 - CONCRETE PAD
 - INFILTRATION DRY WELL
 - BORE HOLE LOCATION AND ELEVATION
SEE GEOTECHNICAL REPORT FOR DETAILS
 - CONCRETE SIDEWALK
 - AS-BUILT PICK UP

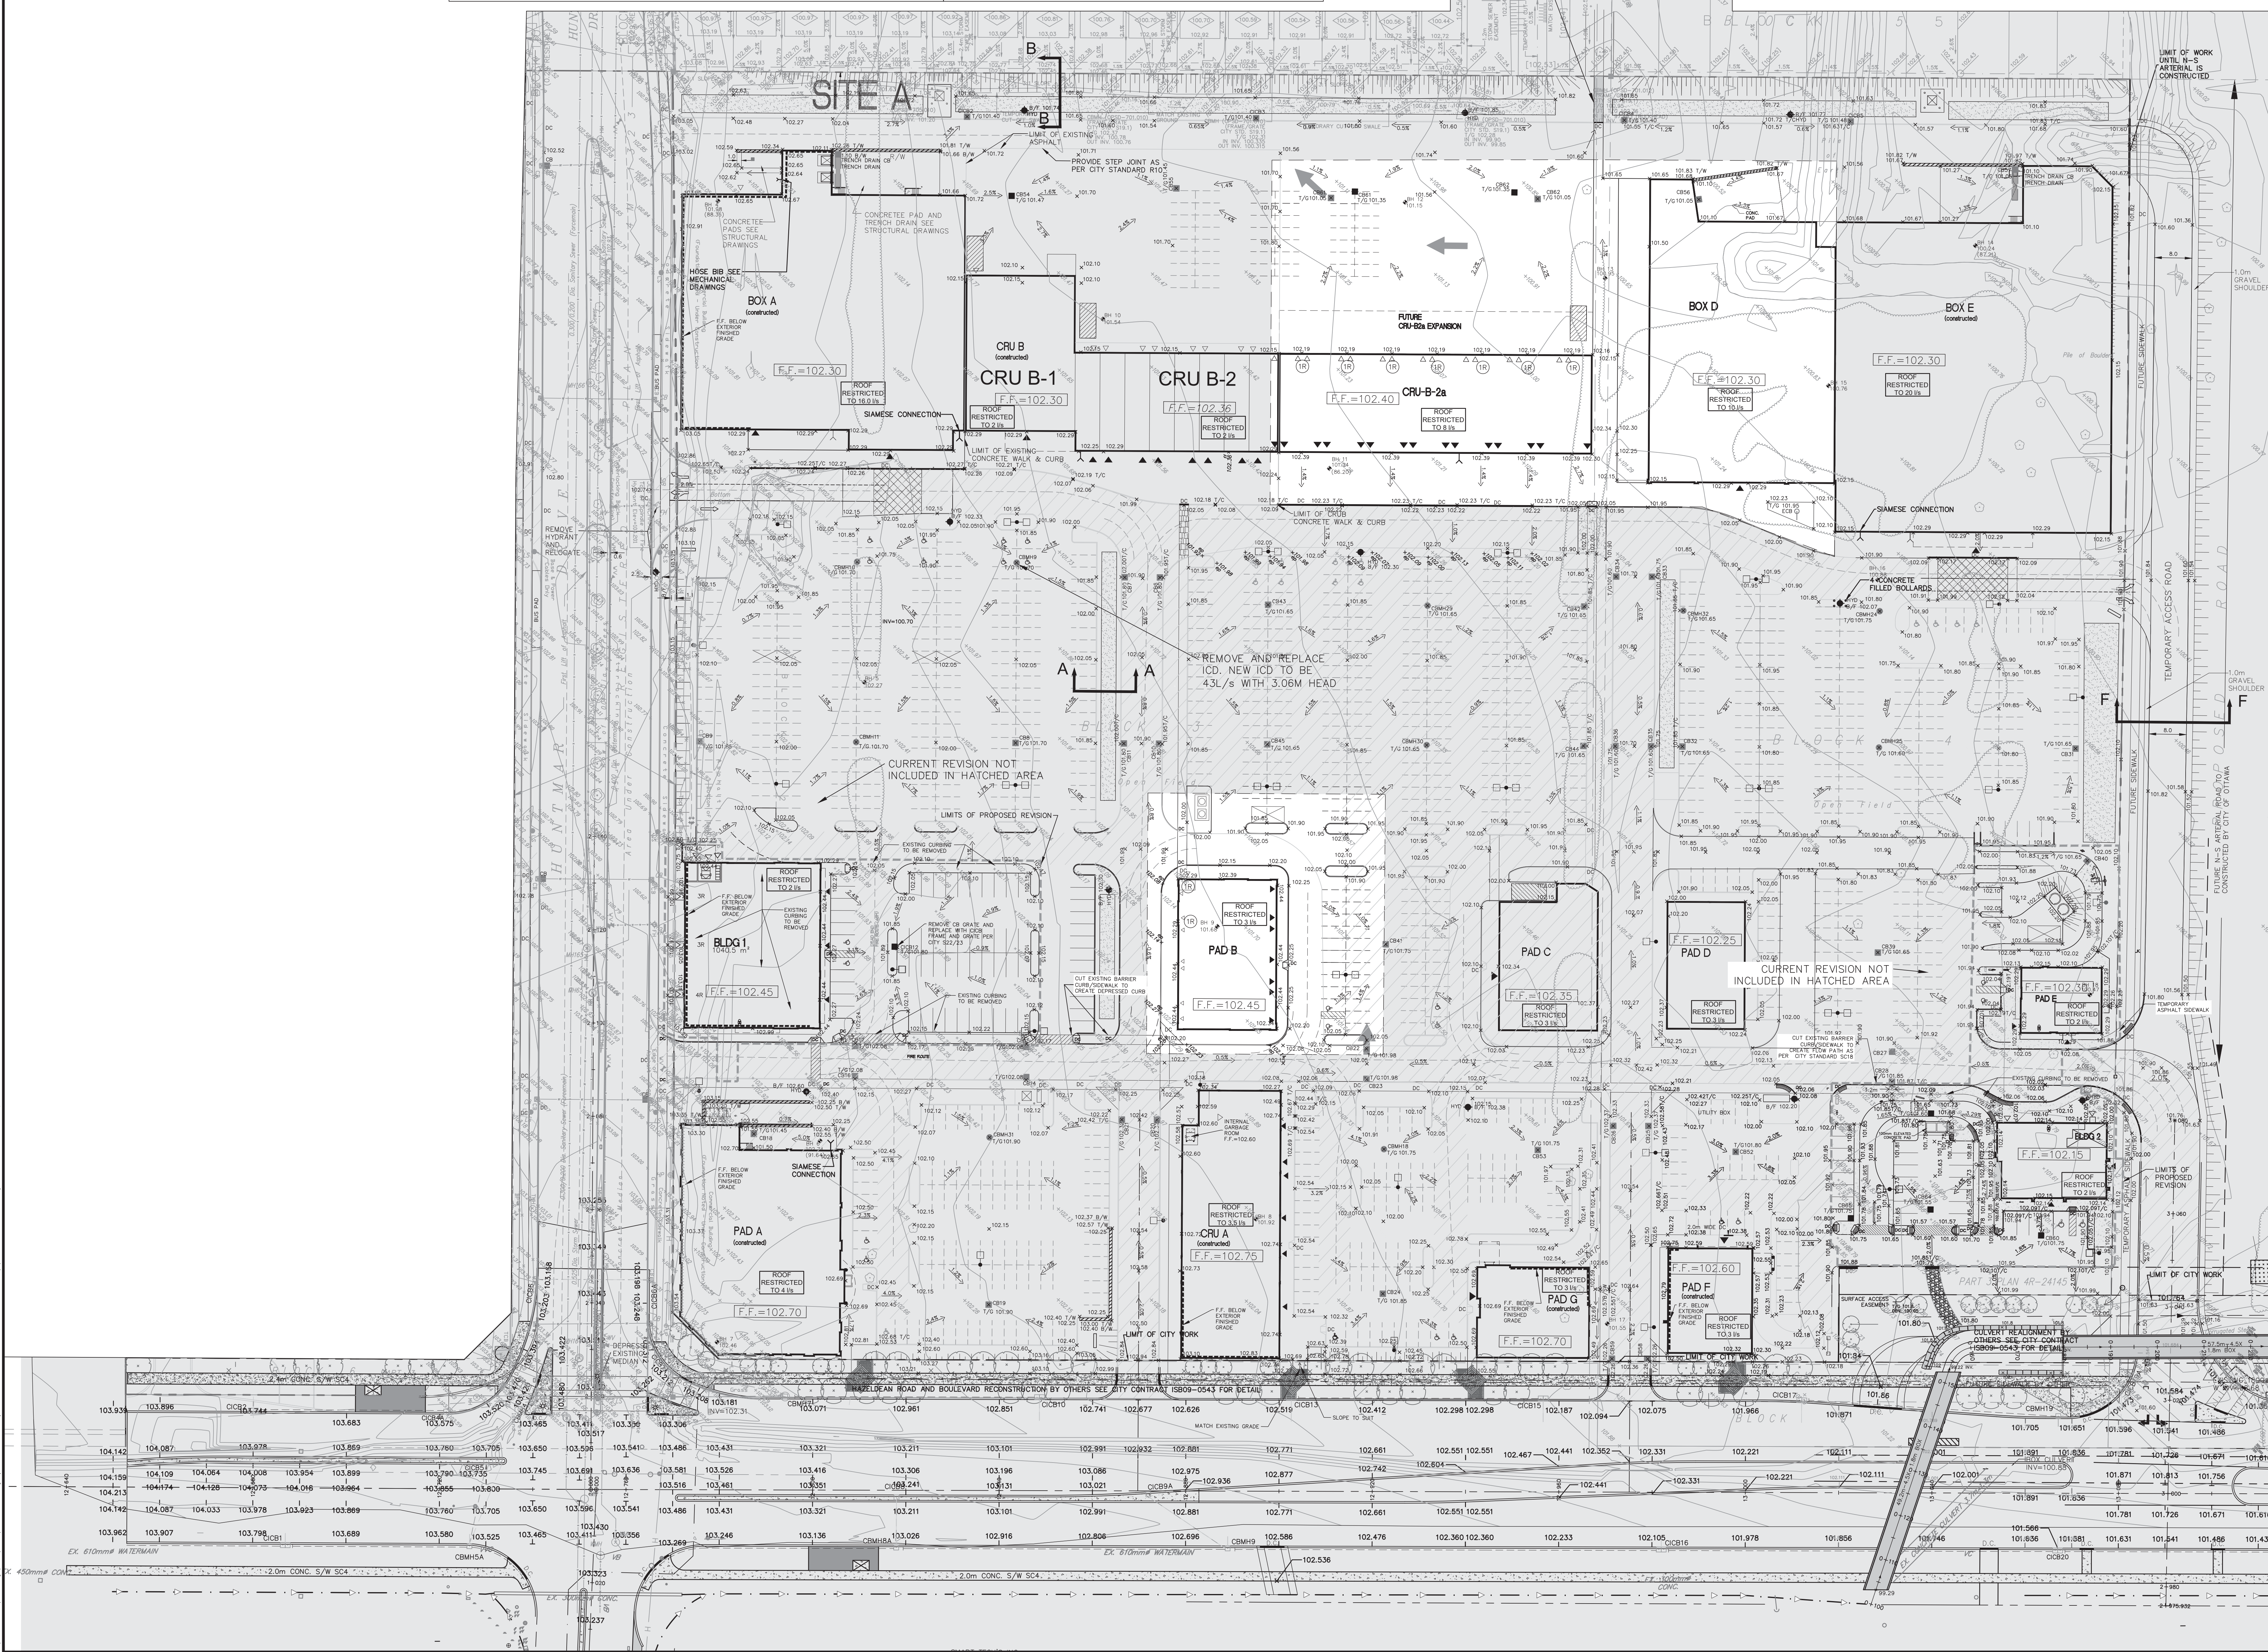

27	REVISED AS PER CITY COMMENTS	DOY	19-12-20
26	ISSUED FOR SPA	DOY	19-08-29
25	REVISED REAR DOOR GRADES PER ARCHITECT	DOY	18-06-18
24	ISSUED FOR CONSTRUCTION	DOY	18-04-06
23	ISSUED FOR TENDER	DOY	18-01-15
22	REVISED AS PER CITY COMMENTS	DOY	17-11-23
21	ISSUED FOR SPA	DOY	17-11-02
20	REVISED AS PER SITE PLAN	DOY	17-09-08
19	REVISED AS PER CITY COMMENTS	DOY	17-07-07
18	REVISED BLD 2 & PAD E	DOY	17-06-23
17	REVISED AS PER CITY COMMENTS	DOY	17-02-14
16	REVISED AS PER CITY COMMENTS	DOY	16-08-05
15	SPA BLDG 1 & 2	DOY	16-03-07
14	REVISED BLDG 1 & 2	DOY	16-01-21
13	REVISED AS PER SITE PLAN	DOY	14-11-03
12	SPA	DOY	14-09-09
11	REVISED AS PER SITE PLAN	DOY	14-07-31
10	REVISED AS PER CITY COMMENTS	DOY	14-07-31
9	REVISED DOLLAR & CRUB	DOY	14-06-03
8	ISSUED FOR PAD F TENDER	DOY	13-02-14
7	REVISED FOR PAD F	DOY	12-11-16
6	REVISED FOR PAD F	DOY	12-08-01
5	REVISED SPRINKLER ROOM	DOY	12-03-09
4	REVISED PER CITY COMMENTS AND PAD E	DOY	12-02-22
3	REVISED FOR BOX E	DOY	12-01-24
2	REVISED SITE PLAN PH1 & PH2	DOY	11-11-28
1	ISSUED FOR APPROVAL	DOY	11-10-27
No.	REVISIONS	By	Date

NORTH AMERICAN DEVELOPMENT GROUP

IBI GROUP

333 Preston Street
Tower 1, Suite 400
Ottawa, Ontario
Canada K1S 5N4
Tel (613) 225-1311
Fax (613) 225-9868

Project Title
5705 HAZELDEAN ROAD
OTTAWA, ONT.

Project No.
10113

Drawing No.
C-202

Scale
1:500

Design
D.G.Y.

Checked
D.G.Y.

Date
OCTOBER 2011

GRADING PLAN
PHASE 1 & 2

Scale
1:500

Design
D.G.Y.

Checked
D.G.Y.

Date
OCTOBER 2011

Project No.
10113

Drawing No.
C-202

Scale
1:500

Design
D.G.Y.

Checked
D.G.Y.

Date
OCTOBER 2011

D07-12-19-0168