

SKETCH TO ILLUSTRATE AS-BUILT GRADES OF
 PART OF LOT 28
 CONCESSION 11
 GEOGRAPHIC TOWNSHIP OF GOULBOURN
 CITY OF OTTAWA
 Prepared by Annis, O'Sullivan, Vollebek Ltd.
 Originally prepared October 23, 2019
 Updated April 18, 2022


Scale 1:400
 Metric
 DISTANCES AND COORDINATES SHOWN ON THIS PLAN
 ARE IN METRES AND CAN BE CONVERTED TO FEET BY
 DIVIDING BY 0.3048.

APR 28 2022
 Date
 E. H. Herweyer
 Ontario Land Surveyor

- Notes & Legend**
- Denotes
- SP - Water Stand Post
 - M+ST - Maintenance Hole (Storm Sewer)
 - M+H - Maintenance Hole (Sanitary)
 - M+H - Maintenance Hole (Hydro)
 - M+H - Maintenance Hole (Rogers)
 - M+H - Maintenance Hole (Unidentified)
 - UP - Utility Pole
 - LS - Light Standard
 - CB - Catch Basin
 - LCB - Landscape Catch Basin
 - CBM - Storm Catch Basin Manhole
 - FH - Fire Hydrant
 - Inv. - Invert
 - T/G - Top of Grade
 - T/S - Top of Spindle
 - GV - Gas Valve
 - VB - Valve Box
 - HH - Handhole
 - - Deciduous Tree
 Ø=0.1 metres unless otherwise noted
 - - Coniferous Tree
 Ø=0.1 metres unless otherwise noted
 - - Bollard
 - △ S - Sign
 - CLF - Chain Link Fence
 - CLF - Diameter
 - +05.00 - Location of Elevations
 - +05.00 - Location of Elevations - April 18, 2022
 - +05.00 - Location of Elevations - June 15, 2016
 - +05.00 - Top of Concrete Curb Elevation
 - C/L - Centreline
 - CCP - Concrete Pipe

ELEVATION NOTES
 1. Elevations shown are geodetic and are referred to the CGVD28 geodetic datum.
 2. It is the responsibility of the user of this information to verify that the job benchmark has not been altered or disturbed and that its relative elevation and description agrees with the information shown on this drawing.

UTILITY NOTES
 1. This drawing cannot be accepted as acknowledging all of the utilities and it will be the responsibility of the user to contact the respective utility authorities for confirmation.
 2. Only visible surface utilities were located.
 3. A field location of underground plant by the pertinent utility authority is mandatory before any work involving breaking ground, probing, excavating etc.

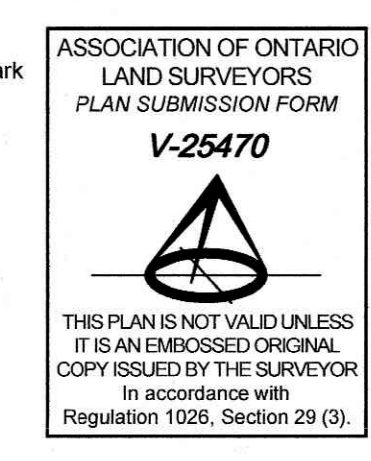

| | | | | | | |
|---------------------------------|-------------------------------|--------------------------------------|----------------------|---------------------------------|----------------|----------------------|
| SUBJECT TO PART 1 PLAN 4R-15806 | EASEMENT PART 6 PLAN 4R-15806 | INST. LT564806E PART 1 PLAN 4R-16491 | PART 1 PLAN 4R-16717 | SUBJECT TO PART 1 PLAN 4R-17647 | INST. OC132105 | PART 10 PLAN 4R-6307 |
| PART 2 PLAN 4R-15806 | PART 5 PLAN 4R-15806 | PART 2 PLAN 4R-16491 | PART 8 PLAN 4R-6307 | PART 9 PLAN 4R-6307 | | |
| PIN 04450 - 1203 | PIN 04450 - 1204 | PIN 04450 - 1238 | PIN 04450 - 1239 | PIN 04450 - 0178 | | PIN 04450 - 0180 |
| LOT 7 | REGISTERED | LOT 8 | PLAN 4M-658 | LOT 9 | | LOT 10 |

BLOCK 19
 0.50 Reserve
 PIN 04450-0180E

ANNIS, O'SULLIVAN, VOLLEBEK LTD.
 14 Concourse Gate, Suite 300
 Nepean, Ont. K2E 7S6
 Phone: (613) 727-0850 / Fax: (613) 727-1079
 Email: info@anniso.com