



re:	Grading, Servicing and Landscape Plan Review			
	Proposed Commercial Building			
	30 Auriga Drive - Ottawa, Ontario			
to:	13799484 Canada Inc. – Mr. Sébastien Brisebois – sbrisebois@bousadainc.com			

date: May 12, 2023

file: PG6513-MEMO.01

Further to your request and authorization, Paterson Group (Paterson) prepared the current memorandum to document our grading, servicing, and landscape plan reviews for the proposed commercial building to be constructed at the aforementioned site. This memo should be read in conjunction with the Geotechnical Investigation Report (Paterson Group Report PG6513-1 dated December 8, 2022).

This memo also acts as our response to Comment B8 provided by the City of Ottawa in the letter dated April 19, 2023 (File No. D07-12-23-0016).

Paterson reviewed the following drawings prepared by McIntosh Perry during the preparation of this memo:

- Site Grading, Drainage, Erosion & Sediment Control Plan Proposed Warehouse 30 Auriga Drive – Project No. CCO-23-0914 – Drawing No. C101 - Revision 2 dated May 17, 2023.
- □ Site Servicing Plan Proposed Warehouse 30 Auriga Drive Project No. CCO-23-0914 Drawing No. C102 Revision 2 dated May 17, 2023.

Paterson also reviewed the following drawing prepared by Nvira for the aforementioned development:


24x36 Landscape – Auriga Entrepot – 30 Auriga Drive - Project No. 3562 – Sheet 1/1 - Revision 1 dated January 20, 2023.

Grading Plan Review

Based on our review of the above-noted Site Grading, Drainage, Erosion & Sediment Control Plan, the proposed grading at the subject site is within the recommended permissible grade raise restriction of 1.2 m provided in the Geotechnical Investigation Report, referenced above. Therefore, the proposed grading is considered acceptable, from a geotechnical perspective, and no lightweight fill or other considerations are required to accommodate the proposed grading.



North Bay

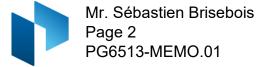

Servicing Plan Review

In reviewing the Site Servicing Plan, referenced above, most of the proposed services have sufficient frost cover. However, insufficient frost protection has been provided to certain storm services, where highlighted on the attached plan. Insulation of the site servicing is recommended where insufficient frost cover has been provided. Our detailed frost protection recommendations are provided below and on the attached plan.


Geotechnical Recommendations

Any portion of the proposed sewer services installed at a depth of 2.1 m below finished grade, or deeper, is considered to have sufficient soil cover for frost protection. However, based on our review, some of the proposed storm services and their subgrades are anticipated to be founded within the frost zone. Where insufficient soil cover is present above the obvert of the pipe, the following frost protection criteria should be followed:

Thermal	Soil Cover Provided	Insulation Dimensions (mm)		
Condition	D (mm)	t (thickness)	L (extension)	
	Less than 1,100	Not Recommended		
	1,100 to 1,400	75	Extend 900 mm horizontally beyond edge face of the sewer	
Unheated	1,400 to 1,700	50	Extend 600 mm horizontally beyond edge face of the sewer	
	1,700 to 2,000	25	Extend 300 mm horizontally beyond edge face of the sewer	

All rigid insulation should consist of either Dow Chemical High-Load 40 (HI-40), Styro Rail SR.P400, or equivalent approved by Paterson. The placement of all insulation within the service trenches must be reviewed and approved by Paterson personnel at the time of construction.

Provided these recommendations are followed, the Site Servicing Plan is considered acceptable, from a geotechnical perspective.

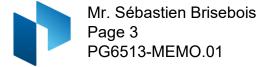

Landscape Plan Review

In reviewing the available Landscape Plan, referenced above, no trees are proposed within 7.5 m of the proposed building. Some shrubs are located within 7.5 m, however, these have shallower root structures than trees, which will not extend to the depths of the proposed foundations. In summary, the proposed Landscape Plan is considered acceptable, from a geotechnical perspective.

We trust that this information satisfies your immediate requirements.

Best Regards,

Paterson Group Inc.


Scott S. Dennis, P.Eng.

Attachment: -Site Servicing Plan mark-ups with recommended pipe insulation



Ottawa Head Office 9 Auriga Drive Ottawa – Ontario – K2E 7T9 Tel: (613) 226-7381 Ottawa Laboratory 28 Concourse Gate Ottawa – Ontario – K2E 7T7 Tel: (613) 226-7381 Northern Office and Laboratory 63 Gibson Street North Bay – Ontario – P1B 8Z4 Tel: (705) 472-5331



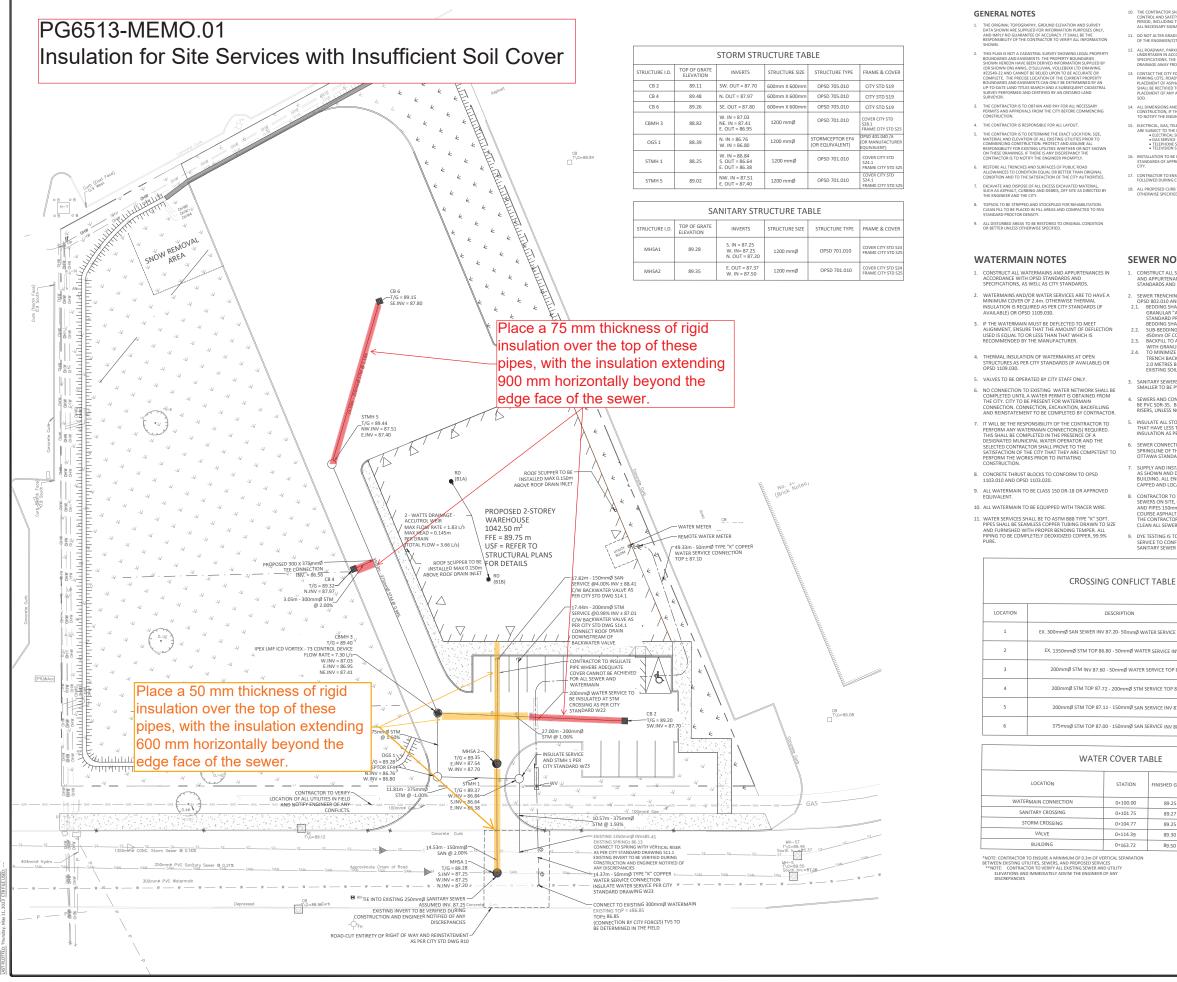

CONTROL AND SAFETY MEASURES DURING THE CONSTRUCTION PERIOD, INCLUDING THE SUPPLY, INSTALLATION, AND REMOVAL DO NOT ALTER GRADING OF THE SITE WITHOUT PRIOR APPROVAL OF THE ENGINEER/CITY

PECIFICATIONS. THE CONTRACTOR IS TO DRAINAGE AWAY FROM THE BUILDING.

CONTACT THE CITY FOR INSPECTION OF ROUL PARKING LOTS, ROADWAYS AND LANDSCAPEL PLACEMENT OF ASPHALT AND TOPSOIL ALLD SHALL BE RECTIFIED TO THE CITY'S SATISFACTH PLACEMENT OF ANY ASPHALT, TOPSOIL, SEED SOD.

ELECTRICAL, GAS, TELEPHONE AND TELEVISION ARE SUBJECT TO THE INDIVIDUAL AGENCY: • ELECTRICAL SERVICE - HYDRO ONE, • GAS SERVICE - INBINGE, • TELEPHONE SERVICE - BELL CANADA, • TELEVISION SERVICE - ROGERS.

TION TO BE IN ACCORDANCE WITH RDS OF APPROVAL AGENCIES HYDR

17. CONTRACTOR TO ENSURE ALL APPLICABLE OPS FOLLOWED DURING CONSTRUCTION 18. ALL PROPOSED CURB TO BE CONCRETE OTHERWISE SPECIFIED.

SEWER NOTES:

CONSTRUCT ALL SEWERS, CATCH BASINS, MANHOLI AND APPURTENANCES IN ACCORDANCE WITH OPSE STANDARDS AND SPECIFICATIONS, AS WELL AS CITY

- SEWER TRENCHING AND BE BEDDING SHALL BE A MINIMUM 150mm OF GRANULAR "A", COMPACTED TO MINIMUM 95% STANDARD PROCTOR DRY DENSITY. CLEAR STONE DDING SHALL NOT BE PERI

- BEUDING SHALL NOT BE PERMITTED.
 25. SUB-BEDING, IF REQUIRED SHALL CONSIST OF 450mm OF COMPACTED GRANULAR "B" "TYPE 1.
 3. BACKFLI DA TL LEAST SOOTM ABOVE TOP OF PIF WITH GRANULAR "A" OR GRANULAR "B" "TYPE 1.
 4.1 OT MINIMIZE DIFFERENTIAL FROST HEAVING, TRENCH BACKFLIL (FROM PAVEMENT SUBGRADE 2.0 METES BELOW FINISHED GRADE) SHALL MAT EXISTING SOIL CONDITIONS.

SANITARY SEWERS AND CONNECTIONS 150 SMALLER TO BE PVC SDR-28.

JEAVER'S AND CONNECTIONS 200mmØ AND LARGER TO BE PVC SDR-35. BEDDING TO BE TYPE "B" EXCEPT AT RISERS, UNLESS NOTED OTHERWISE.

INSULATE ALL STORM AND SANITARY SEWERS/SERVICES THAT HAVE LESS THAN 2.0m OF COVER WITH THERMAL INSULATION AS PER OPSD 1109.030.

SEWER CONNECTIONS ARE TO BE MADE ABOVE TH SPRINGLINE OF THE SEWERMAIN AS PER CITY OF OTTAWA STANDARD DRAWING S11, S11.1 & S11.2.

SUPPLY AND INSTALL ALL PIPING AND APPURTENANCE BUILDING. ALL ENDS OF SERVICES TO BE PROPERLY CAPPED AND LOCATED WITH 2"x4"X8' LONG MARKE

CONTRACTOR TO TELEVISE (CCTV) ALL PROPOSED SEWERS ON SITE, OUTLET CONNECTION TO THE N AND PIPES 150mmØ OR GREATER PRIOR TO BASE COURSE ASPHALT. UPON COMPLETION OF CON CLEAN ALL SEWERS & APPURTENANCES

 DYE TESTING IS TO BE COMPLETED ON SANITARY SERVICE TO CONFIRM PROPER CONNECTION TO SANITARY SELVED MAIN SERVICE TO CONI

	-
	SEPARATION
Ø WATER SERVICE TOP 86.67	0.53
WATER SERVICE INV = 87.3	0.50
TER SERVICE TOP 86.85	0.75
TM SERVICE TOP 88.09	0.37
AN SERVICE INV 87.62	0.51
SAN SERVICE INV 88.16	1.16

I	FINISHED GRADE	TOP OF PIPE	COVER		
)	89.25	86.85	2.40		
5	89.27	86.67	2.60		
7	89.25	87.35	1.90		
)	89.30	86.90	2.40		
2	89.50	87.10	2.40		

