

re: Geotechnical Review – Grading Plan Review
Proposed Residential Development
3317 Navan Road - Ottawa, Ontario

to: Renfroe Land Management – **Mr. David Renfroe** – davidrenfroe@outlook.com

date: February 27, 2024

file: PG6582-MEMO.04

Further to your request and authorization, Paterson Group (Paterson) prepared the current memorandum to complete a grading plan review and light weight fill (LWF) design recommendations for the proposed multi-storey development at the aforementioned site. The following memorandum should be read in conjunction with the following reports:

- Paterson Group Report PG6582-1 Revision 1, dated January 29, 2024
- Project No. 118076 – 3317 Navan Road - Drawing No. 118076-GR Revision 3– Grading and Erosion & Sediment Control Plan, dated February 14, 2024, prepared by Novatech.
- Project No. 118076 – 3317 Navan Road - Drawing No. 118076-GP Revision 3– General Plan of Services, dated February 14, 2024, prepared by Novatech.

1.0 Background Information

Paterson completed a review of the above noted grading plan. The subsurface conditions on site consist of a layer of loose to compact layer of brown silty sand to sandy silt, underlain by a very stiff to stiff brown silty clay. A stiff to firm grey silty clay was observed underlying the brown silty clay deposit. Due to the presence of a silty clay deposit a permissible grade raise restriction was recommended for the site. Based on available information and the measured shear strength, consistency and Paterson’s experience in the area, the permissible grade raise restriction can be taken at **0.5 m above the native ground surface**.

The following section will summarize our review of the proposed grading plan in conjunction with the permissible grade raise restrictions and LWF design provided in the current memorandum.

2.0 Grading Plan Review

Based on our review of the above noted drawing, the proposed grading for the residential unit exceeds the permissible grade raise recommendations. Our lightweight fill recommendations are presented in the grading plan attached to the end of this report.

The LWF material should consists of EPS 15 under pavement and other parking structures and EPS 12 under soft landscaped areas. The LWF should be placed against the foundation wall, above the footing and a minimum of 600 mm below the finish surface. The LWF EPS blocks should extend a minimum of 2.4 m from the foundation wall with the thicknesses recommended in the attached marked up grading plan.

It is not recommended to plant medium to large trees directly above the LWF EPS. The EPS should be covered with a polyethylene sheet and surrounded with a non-woven geotextile such as Terrafix 270R. Minimum of 300 mm of OPSS Granular A should be placed above the LWF under any pavement structures and minimum 500 mm of approved fill layer should be provided on top of the LWF can consist of fill soil covered with a minimum of 100 of topsoil where soft landscaping is proposed.

Lightweight fill material specifications and cover recommendations are provided in Figure 1 attached to the current report.

Where LWF is placed under an interlock pavement structures or concrete slabs, the fill on top of the EPS block should consist of a minimum layer of 300 mm of imported OPSS Granular A.

Paterson should review the LWF placement and complete compaction testing on imported fill during the construction activities.

2.1 Underground Service Pipes

Based on our review of the grading plan, it was found that the several deep services were observed. It is recommended to place LWF above the services where a grade raise exceedance has been observed. Our lightweight fill recommendations are presented in the grading plan attached to the end of this report. It is recommended to place EPS-15 LWF, surrounded by a non-woven geotextile such as Terrafix 270R above the service pipes.

Furthermore, based on the abovementioned site plans, it was noted that the proposed invert elevation of the sanitary service line from SANMH103 and SANMH 101 located along the eastern side building was observed to be located below the proposed USF elevation of the buildings. In order to avoid undermining the footings and to protect the service pipes from the footing loads, one of the following options can be followed:

Option 1 – Extend Footing and Foundation Wall

The depth of the footing and the foundation wall can be stepped down to extend below the invert elevation of the service lines – below geodetic elevation of 81.50 m along SANMH 103 and below geodetic elevation of 82.10 m along SANMH 101, such that, the service line inlets pass through the building foundation wall. This will require no additional protection around the service pipes entering the building.

Option 2: Lean Concrete Infilled Trenches

As an alternative, the depth of the footings can be increased to extend approximately 150 mm below the invert elevation of the service pipes (or thickness of the pipe bedding if different) through lean concrete infilled (minimum 15 MPa), near vertical trenches. The service pipes can then be extended under the footings through the lean concrete.



Where the service pipes pass through the lean concrete, they should be surrounded by minimum 150 mm of geospan fill.

Note that the attached recommended LWF thickness for these areas have been adjusted to take in consideration the extra fill required to backfill the services trench near the footings.

Furthermore, all other service lines were observed to be above the USF elevation of the buildings.

2.2 Pavement and Parking Areas

Based on our review of the grading plan, it was found that the north access lane and parking areas have exceeded the permissible grade raise. To protect proposed services and retaining wall LFW is recommended under the pavement structure.

Where LWF is required in the parking and access lanes, as indicated in attached mark ups, minimum 100 mm of HI-60 rigid insulation should be placed on the level native soil surface prior to the installation of the granular pavement base and subbase. The rigid insulation should be covered with a non-woven geotextile such as Terrafix 270 R.

2.3 Bearing Resistance Value

Based on our review of the abovementioned grading plan, it was noted that the underside of footings of the proposed buildings will be founded will be at a geodetic elevation of 82.75 m. Based on the proposed USF elevation it is anticipated that the footings will be placed over a firm grey silty clay to loose to compact brown silty sand bearing medium surface.

Strip footings up to 2 m wide and pad footings up to 4 m wide, placed over an undisturbed firm silty clay or on engineered fill placed directly over the undisturbed firm silty clay can be designed using a bearing resistance value at Serviceability Limit States (SLS) of **60 kPa** and a factored bearing resistance value at Ultimate Limit States (ULS) of **100 kPa**, incorporating a geotechnical factor of 0.5 at ULS.

Conventional footings placed over a compact silty sand bearing surface can be designed using a bearing resistance value at Serviceability Limit States (SLS) of **100 kPa** and a factored bearing resistance value at Ultimate Limit States (ULS) of **150 kPa**, incorporating a geotechnical factor of 0.5 at ULS. Where the silty sand is found in a loose state of compactness, it is recommended to proof roll the sand using a suitable vibratory equipment, making several passes, under dry conditions and above freezing temperatures. The proof roll should be reviewed and approved by Paterson.

3.0 Frost Protection – Service Pipes

Based on our review of the abovementioned site servicing plan, it was observed that some portions of the proposed storm service lines will have less than 2 m of soil cover. Where



insufficient soil cover (i.e.- less than 2.0 m) is available, the following frost protection criteria outlined in Table 1 below.

Soil Cover Provided D (mm)	Insulation Dimensions (mm)	
	Thickness (mm)	Length (mm)
1,100 to 1,400	75	Extend 900 mm horizontally beyond the edge face of the pipe
1,400 to 1,700	50	Extend 600 mm horizontally beyond the edge face of the pipe
1,700 to 2,000	50	Extend 300 mm horizontally beyond the edge face of the pipe

The rigid insulation should be placed 150 mm above the pipe on top of a compacted Granular A backfill and should have a minimum of 150 mm of Granular A backfill above the rigid insulation.

Rigid insulation placed underneath roadways less than 1.2 m from the surface should consist of high density extruded polystyrene HI-60 or better. At larger depth HI-40 or better can be used.

Any portion of the storm service pipe installed at a depth of 2.0 m below finished grade or deeper is considered acceptable from a geotechnical perspective.

3.0 Preloading / Surcharge Program

It is possible to surcharge the subject site in localized areas provided sufficient time is available to achieve the desired settlements based on theoretical values from the settlement analysis. If this option is considered, a monitoring program using settlement plates and electronic piezometers will have to be implemented. This program will determine the amount of settlement in the preloaded or surcharged areas. Preloading to proposed finished grades will allow for consolidation of the underlying clays over a longer time period. Surcharging the site with additional fill above the proposed finished grade will add additional load to the underlying clays accelerating the consolidation process and allowing for accelerated settlements. Once the desired settlements are achieved, the site can be unloaded, and the fill can be used elsewhere on site.

Surcharge programs can completely remove the requirement for LWF on the project, while preloading will most likely diminish the total amount required.

With both the preloading and surcharging methods, the loading period can be reduced by installing vertical wick drains or sand drains in the silty clay layer to promote the movement of groundwater towards the ground surface. However, vertical drains are expensive for this type of residential project.

4.0 Ground Improvement

As an alternative to a surcharge program, ground improvement techniques can be implemented in localized areas, to help reduce the LWF requirements. Ground improvement techniques such as control modulus columns (CMC) could be installed under the main structure and foundation system to increase the bearing capacity of the underlying soils.

The design and drawings for these should be completed by the specialized geotechnical contractor. It should be noted that ground improvement is not considered as structural elements.

If ground improvement is completed under the extent of the proposed building, the LWF requirements can be reduced or lifted for the proposed building. It should be noted that the extent of the proposed ground improvement is limited to the building. Settlement is expected in the areas of soft landscaping. Those areas may require slight maintenance with additional topsoil to infill slightly settled vegetated areas.

Recommendations for pavement and parking areas are still applicable following the implementation of the ground improvement program.

If ground improvement is selected for the project, the bearing capacity under the proposed foundation will be significantly increased.

We trust that the current submission meets your immediate requirements.

Best Regards,

Paterson Group Inc.



Pratheep Thirumoolan, M.Eng.



Joey R. Villeneuve, M.A.Sc., P.Eng.

PG6582 - Light Weight Fill markup - Buildings and Pavement

LEGEND





	PROPOSED ELEVATION
	EXISTING ELEVATION
	PROPOSED TERRACE ELEVATION
	GRADE AND DIRECTION
	MAXIMUM 3:1 SIDESLOPE
	EMERGENCY OVERLAND FLOW ROUTE
	PROPOSED SANITARY MANHOLE
	PROPOSED CATCHBASIN MANHOLE
	PROPOSED STORM MANHOLE
	PROPOSED CATCHBASIN
	PROPOSED HYDRANT AND VALVE
	PROPOSED BARRIER CURB (PER SC1.1)
	PROPOSED DEPRESSED CURB (PER SC1.1)
	PROPOSED INLET CONTROL DEVICE
	PROPOSED ROOF DRAIN
	PROPOSED TWI
	PROPOSED FINISHED FLOOR ELEVATION
	PROPOSED UNDERSIDE OF FOOTING ELEVATION
	PROPOSED BASEMENT FLOOR ELEVATION
	PROPOSED TOP OF FOUNDATION ELEVATION
	APPROXIMATE PONDING LIMITS

PROPOSED MUD MAT / CONSTRUCTION ENTRANCE

	PROPOSED MUD MAT / CONSTRUCTION ENTRANCE
	EXISTING CONCRETE CURB
	EXISTING SANITARY MANHOLE
	EXISTING STORM MANHOLE
	EXISTING HYDRANT
	EXISTING TREES / VEGETATION
	EXISTING UTILITY POLE
	EXISTING FENCE
	EXISTING LIGHT STANDARD

PAVEMENT STRUCTURES:



Location	Proposed Pavement Structure	Notes
Light Duty (Car Only Parking Areas)	40mm HL or SP 12.5 ASPHALTIC CONCRETE 150mm GRAN "A" 300mm GRAN "B" TYPE II	*INSTALLED PER GEOTECHNICAL REPORT
Heavy Duty (Access Lanes)	40mm HL or SP 12.5 ASPHALTIC CONCRETE 50mm HL or SP 10.0 ASPHALTIC CONCRETE 150mm GRAN "A" 400mm GRAN "B" TYPE II	*INSTALLED PER GEOTECHNICAL REPORT

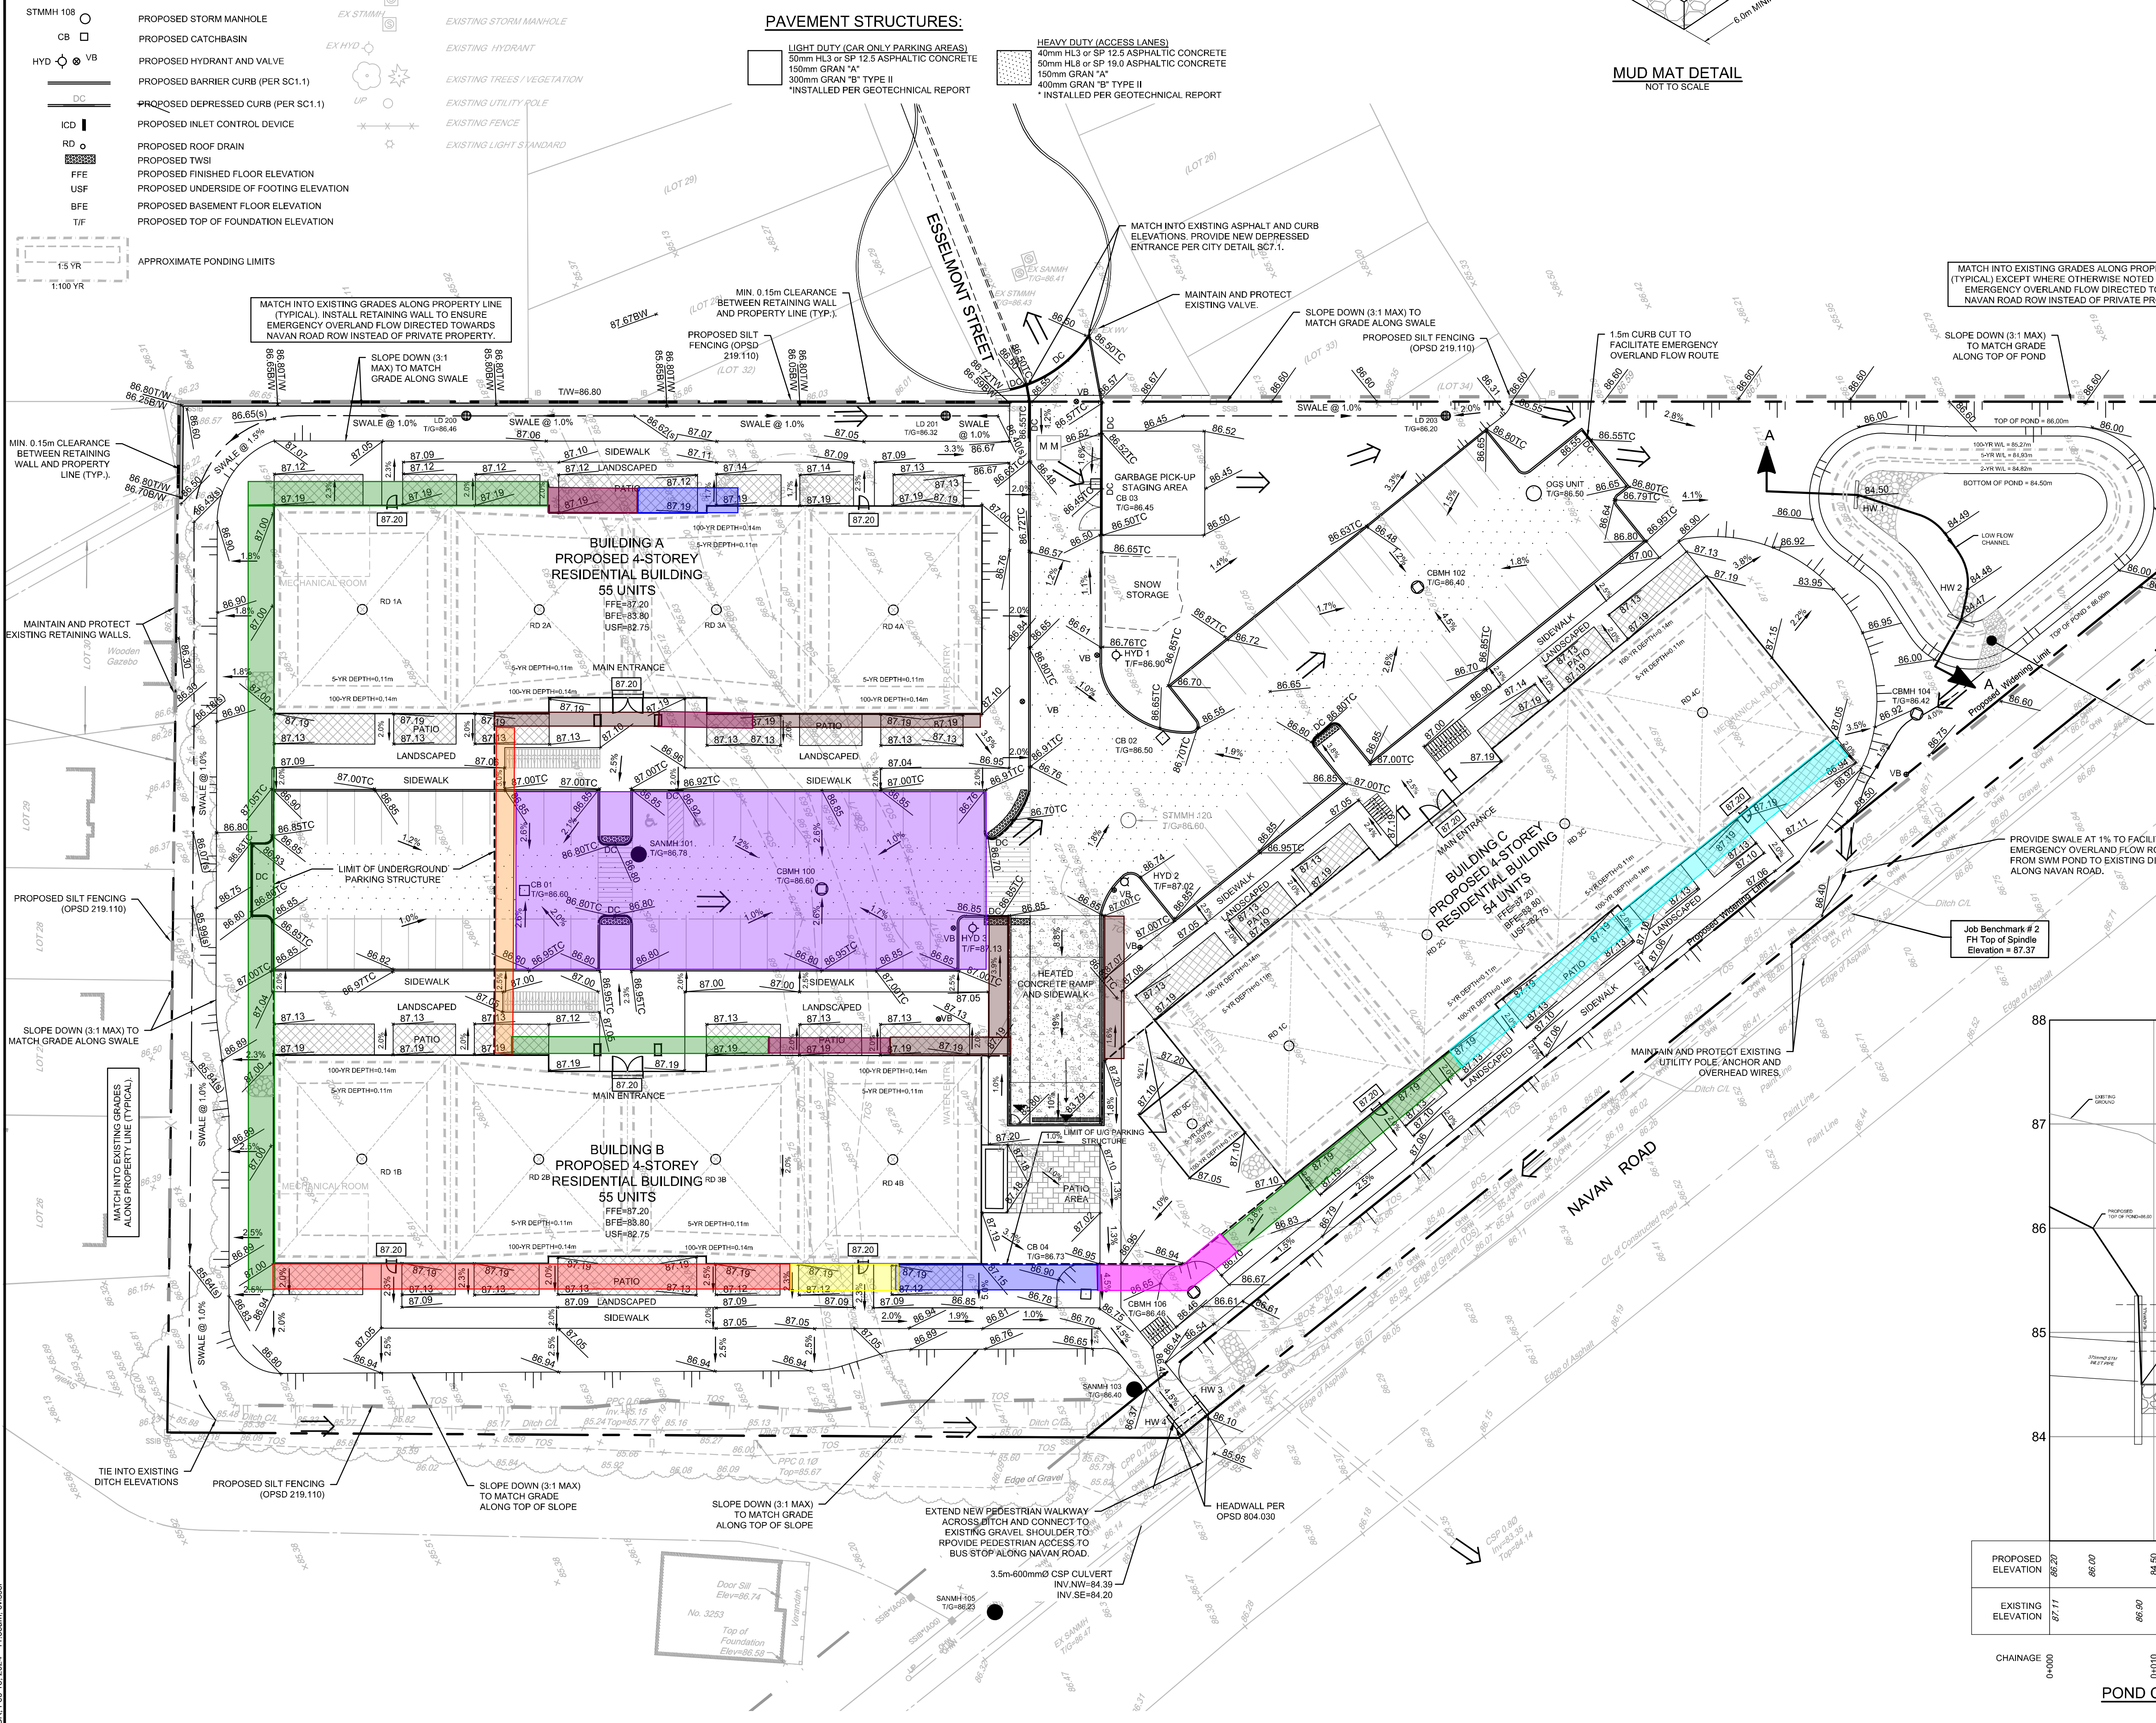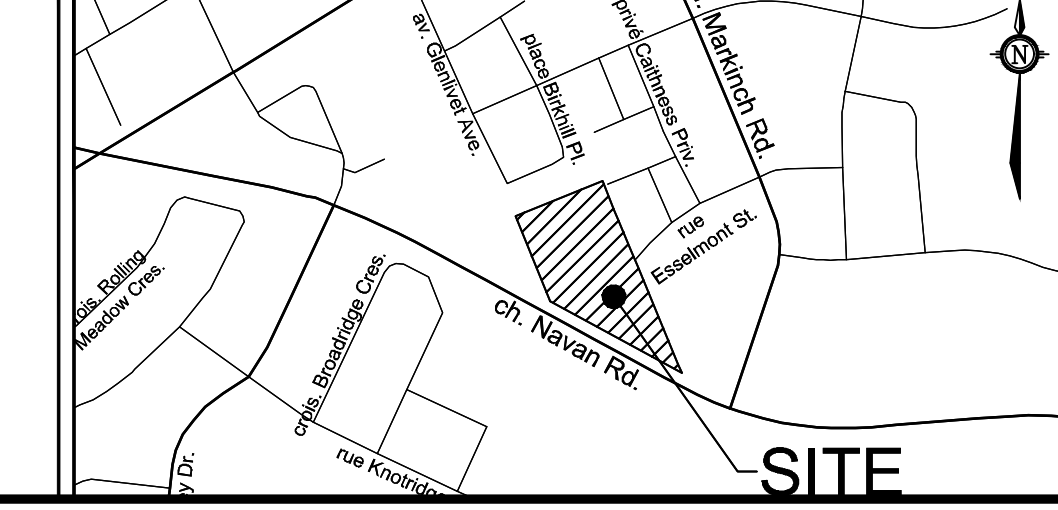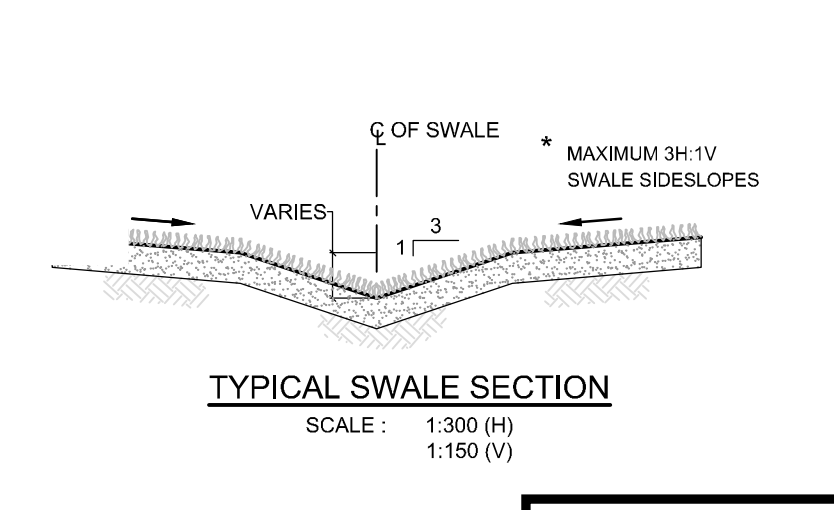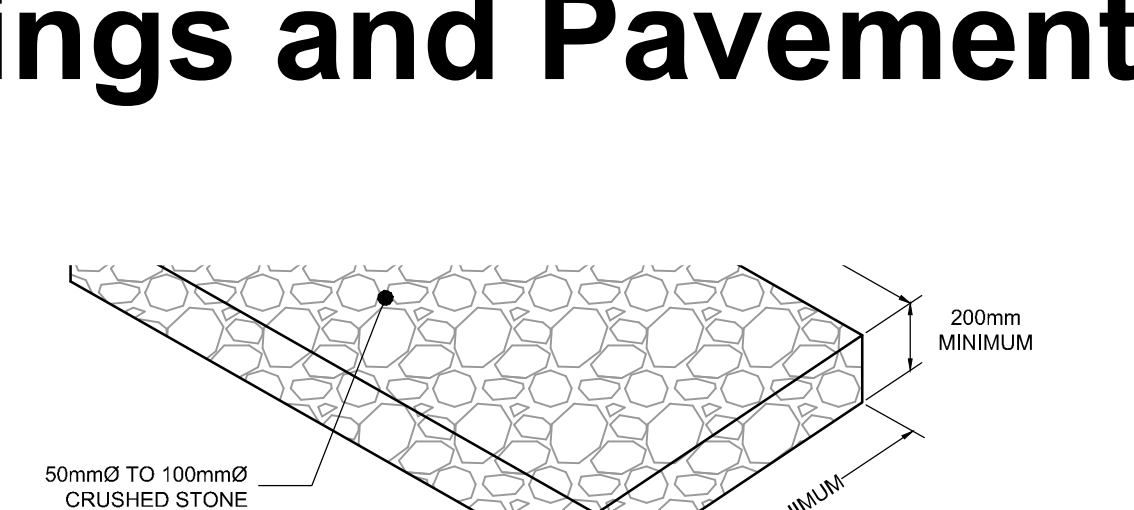

Recommended Light Weight Fill Volume (m³)

	Minimum 0.3 m thick EPS LWF	114.5 m² x 0.3 m = 15.9 m³
	Minimum 0.5 m thick EPS LWF	77 m² x 0.5 m = 38.5 m³
	Minimum 0.8 m thick EPS LWF	380 m² x 0.8 m = 304 m³
	Minimum 1.0 m thick EPS LWF	183 m² x 1.0 m = 183 m³
	Minimum 1.2 m thick EPS LWF	119 m² x 1.2 m = 142.8 m³
	Minimum 1.5 m thick EPS LWF	67.2 m² x 1.5 m = 100.8 m³
	Minimum 1.7 m thick EPS LWF	24.5 m² x 1.7 m = 41.7 m³
	Minimum 1.9 m thick EPS LWF	68.2 m² x 1.9 m = 129.6 m³
	Minimum 2.2 m thick EPS LWF	35 m² x 2.2 m = 77 m³
	Minimum 0.1 m thick HI-40 RI	765 m² x 0.1 m = 76.5 m³

Note: Parking Area between Building A and B should have HI-60 Rigid Insulation as shown in the typical car parking profile

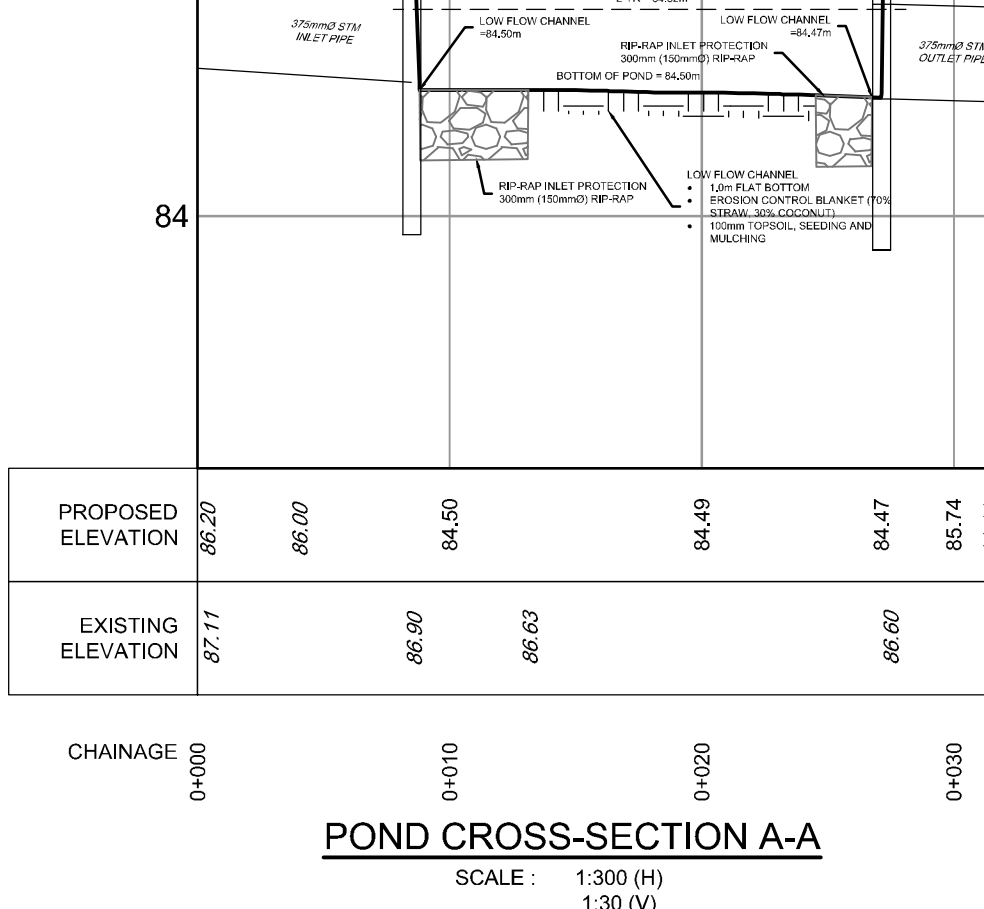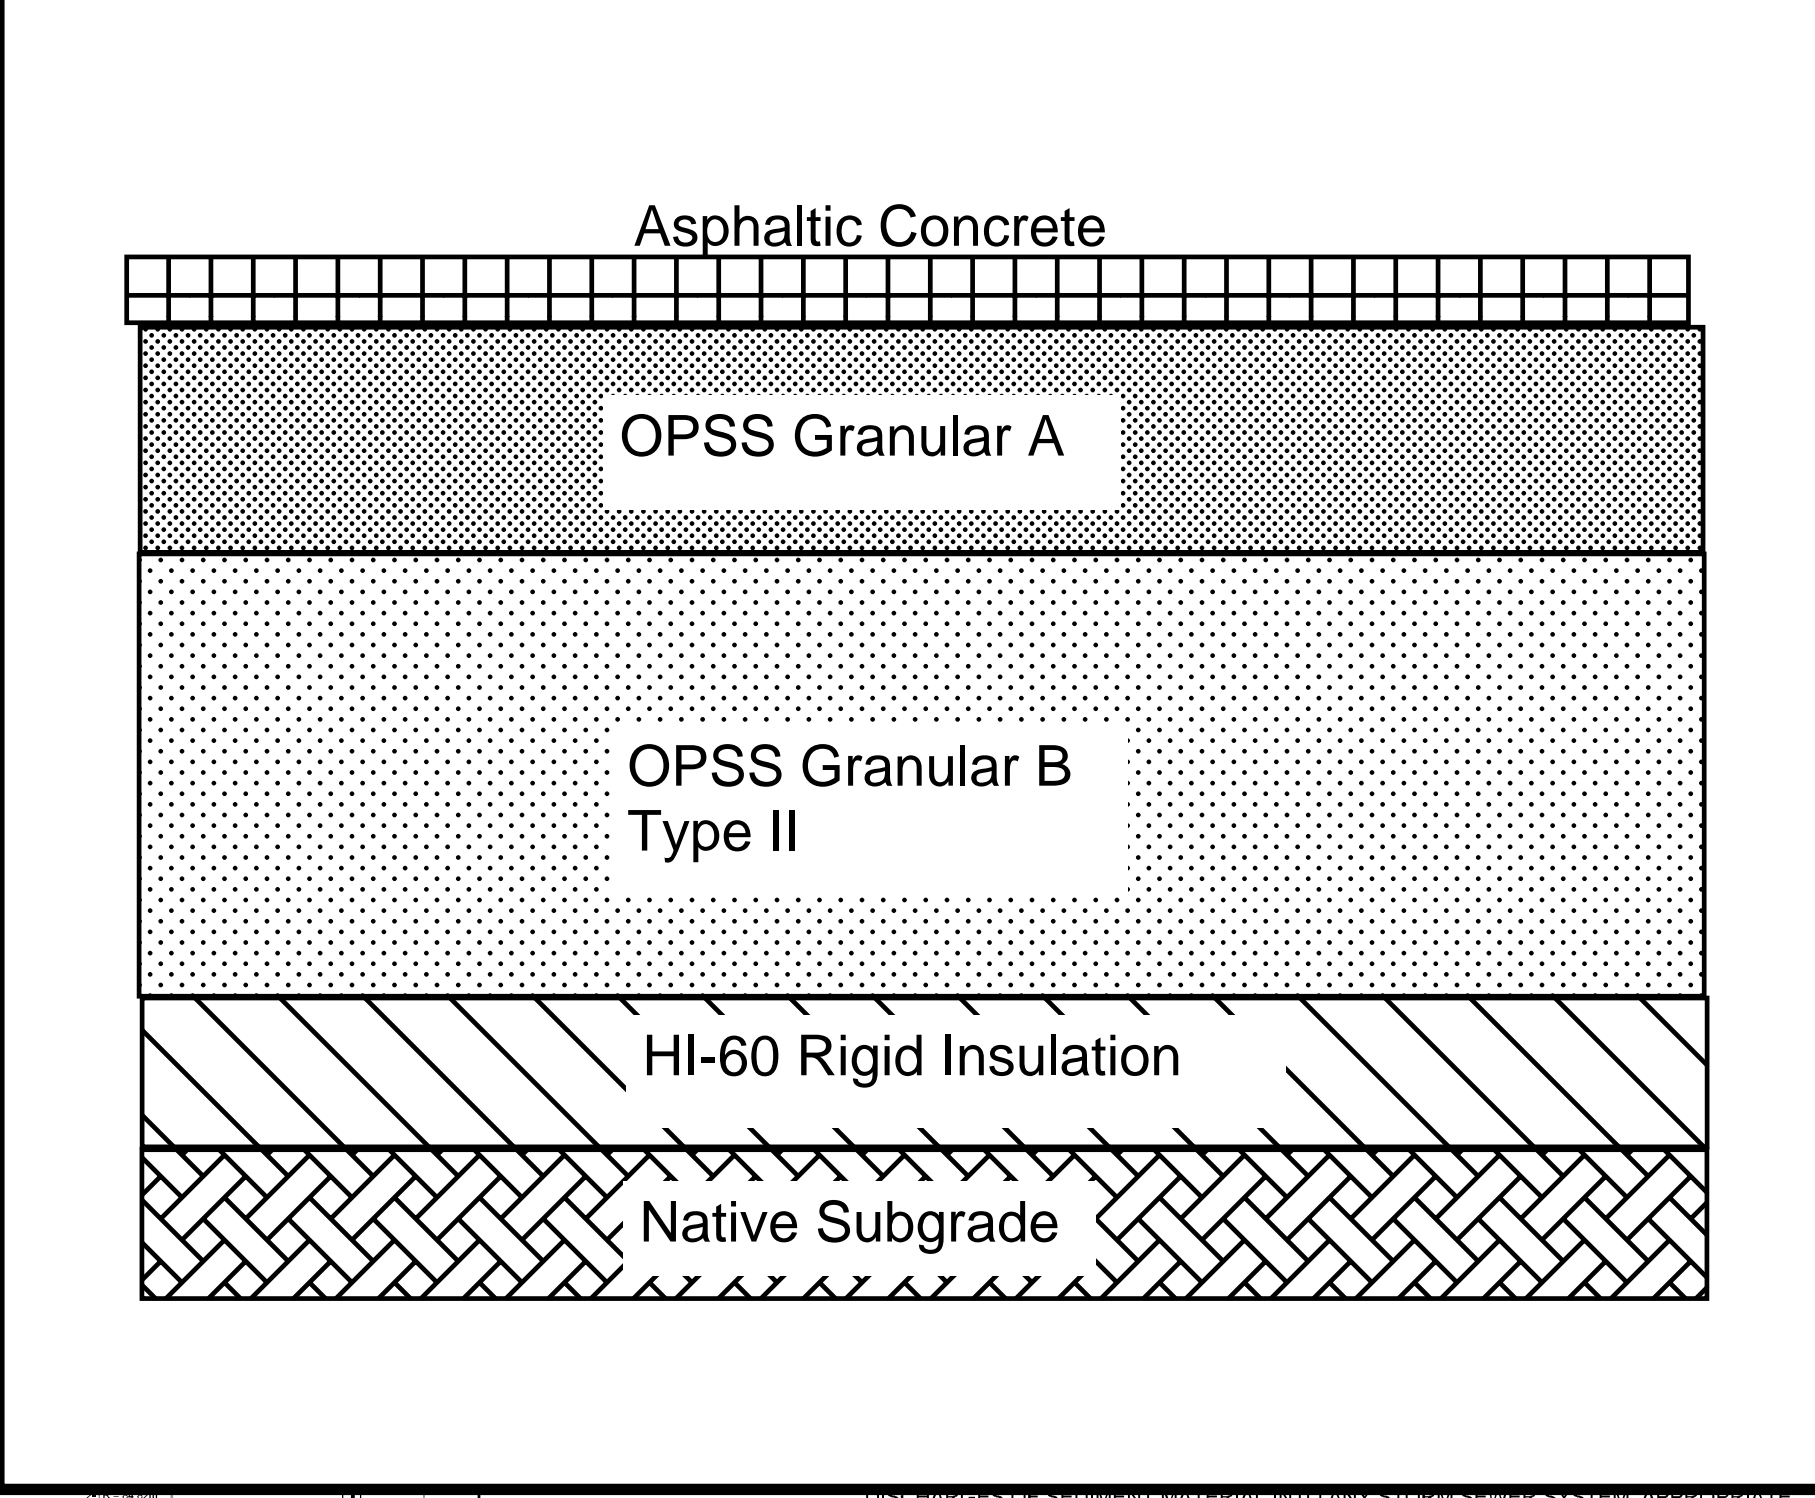

BENCHMARK NOTES:

- ELEVATIONS SHOWN ARE GEODETIC AND ARE REFERRED TO THE CGVD25 GEODETIC DATUM, DERIVED FROM CONTROL MONUMENT 001 19659327 HAVING AN ELEVATION OF 86.707 METRES.
- IT IS THE RESPONSIBILITY OF THE USER OF THIS INFORMATION TO VERIFY THAT THE JOB BENCHMARK HAS NOT BEEN ALTERED OR DISTURBED AND THAT ITS RELATIVE ELEVATION AND DESCRIPTION AGREES WITH THE INFORMATION SHOWN ON THIS DRAWING.
- BENCHMARK WAS PROVIDED ON TOPOGRAPHIC PLAN OF SURVEY OF PART OF LOT 4, CONCESSION 4 (OTAWA FRONT) GEOGRAPHIC TOWNSHIP OF GLOUCESTER, CITY OF OTTAWA, SURVEYED BY ANNIS, O'SULLIVAN AND VOLEBEK LTD.

NOTE: THE POSITION OF ALL POLE LINES, CONDUITS, WATERMANS, SEWERS AND OTHER UNDERGROUND AND OVERGROUND UTILITIES AND STRUCTURES IS NOT NECESSARILY SHOWN ON THE CONTRACT DRAWINGS, AND WHERE SHOWN, THE ACCURACY OF THE POSITION OF SUCH UTILITIES AND STRUCTURES IS NOT GUARANTEED. BEFORE STARTING WORK, DETERMINE THE EXACT LOCATION OF ALL SUCH UTILITIES AND STRUCTURES AND ASSUME ALL LIABILITY FOR DAMAGE TO THEM.

OWNER INFORMATION
262576 ONTARIO INC.
231 BRITANNY DRIVE, SUITE D
OTTAWA, ONTARIO, K1K 0R8
LALIT AGGARWAL
PHONE: (613)-746-1647
lsa@manorparkcap.com

No.	REVISION	DATE	BY
3.	REVISED PER CITY COMMENTS	FEB 14/24	FST
2.	REVISED PER CITY COMMENTS	NOV 13/23	FST
1.	ISSUED FOR SITE PLAN CONTROL APPROVAL	JUNE 8/23	FST

FOR REVIEW ONLY

DESIGN	ZAC/V
CHECKED	FST
DRAWN	ZAC/V
CHECKED	FST
APPROVED	FST

NOVATECH
Engineers, Planners & Landscape Architects
Suite 200, 249 Michael Cowland Drive
Ottawa, Ontario, Canada K2M 1P6
Telephone: (613) 254-9643
Facsimile: (613) 254-5867
Website: www.novatech-eng.com

LOCATION
CITY OF OTTAWA
3317 NAVAN ROAD

DRAWING NAME
GRADING AND EROSION & SEDIMENT CONTROL PLAN

PROJECT No. 118076
REV # 3
DRAWING No. 118076-CR
Plan # 19008

D07-12-23-0085

PG6582 - Light Weight Fill markup - Series

LEGEND

PROPERTY LINE	PR	AN
PROPOSED SANITARY MH & SEWER	FF	PR
PROPOSED CATCHBASIN MANHOLE & SEWER	BF	PR
PROPOSED STORM MANHOLE & SEWER	ST	PR
PROPOSED CATCHBASIN AND LEAD	CB	PR
PROPOSED HYDRANT AND VALVE	HY	PR
PROPOSED BARRIER CURB	BC	PR
PROPOSED DEPRESSIONED CURB	DC	PR
PROPOSED WATERMAIN AND DIAMETER	WM	PR
PROPOSED VALVE BOX	VB	PR
PROPOSED BEND AND THRUSTBLOCK	B	PR
PROPOSED CAP	C	PR
PROPOSED INLET CONTROL DEVICE	ICD	PR
PROPOSED TWSI	TWSI	PR
THERMAL INSULATION FOR SHALLOW SEWERS	INS	PR
PROPOSED BUILDING ENTRANCE	BE	PR
PROPOSED RETAINING WALL	RW	PR

PROPOSED 200mmØ-150mmØ BLDG B WATER SERVICE TABLE

STATION	SURFACE ELEVATION	TWM ELEVATION	COMMENTS
2+000.0	86.73	84.22	TEE
2+005.3	86.95	84.30	45° HORIZONTAL BEND
2+014.6	86.70	84.30	45° HORIZONTAL BEND
2+016.4	86.67	84.27	CROSS BELOW 375mmØ STM (±0.67m CLEARANCE)
2+022.6	86.80	84.40	HYDRANT TEE
2+023.9	86.82	84.40	200mmx150mm REDUCER
2+032.8	87.10	84.60	150mmØ VALVE AND VALVE BOX
2+035.2	87.19	84.60	CAP 1.0m FROM BUILDING

AREA A-2: ICD TABLE - CBMH 104

DESIGN EVENT	TYPE OF ICD	DIAMETER OF OUTLET PIPE (mm)	DESIGN FLOW (L/s)	DESIGN HEAD (m)	WATER DEPTH (m)	VOLUME (m³)
1.2 YR	118mm DIA. ORIFICE	375	13.5	0.20	84.82	84.8
1.5 YR	PLUG TYPE ICD		16.8	0.31	84.93	116.4
1.100 YR			24.3	0.65	85.27	242.9

ROOF DRAIN TABLE

AREA ID	ROOF DRAIN NO. (WATTS MODEL)	ROOF DRAIN OPENING SETTING	2 YEAR RELEASE RATE	APPROX. 5-YR PONDING DEPTH	5-YEAR RELEASE RATE	APPROX. 100-YR PONDING DEPTH	100-YEAR RELEASE RATE	APPROX. 100-YR PONDING DEPTH
R-1	RD 1A (RD-100-A-ADJ)	1/4 EXPOSED	0.72 L/s	10 cm	0.82 L/s	11 cm	0.91 L/s	14 cm
R-1	RD 2A (RD-100-A-ADJ)	1/4 EXPOSED	0.72 L/s	10 cm	0.82 L/s	11 cm	0.91 L/s	14 cm
R-1	RD 3A (RD-100-A-ADJ)	1/4 EXPOSED	0.72 L/s	10 cm	0.82 L/s	11 cm	0.91 L/s	14 cm
R-1	RD 4A (RD-100-A-ADJ)	1/4 EXPOSED	0.72 L/s	10 cm	0.82 L/s	11 cm	0.91 L/s	14 cm
R-1	RD 1B (RD-100-A-ADJ)	1/4 EXPOSED	0.72 L/s	10 cm	0.82 L/s	11 cm	0.91 L/s	14 cm
R-2	RD 2B (RD-100-A-ADJ)	1/4 EXPOSED	0.72 L/s	10 cm	0.82 L/s	11 cm	0.91 L/s	14 cm
R-2	RD 3B (RD-100-A-ADJ)	1/4 EXPOSED	0.72 L/s	10 cm	0.82 L/s	11 cm	0.91 L/s	14 cm
R-2	RD 4B (RD-100-A-ADJ)	1/4 EXPOSED	0.72 L/s	10 cm	0.82 L/s	11 cm	0.91 L/s	14 cm
R-3	RD 1C (RD-100-A-ADJ)	1/4 EXPOSED	0.72 L/s	10 cm	0.82 L/s	11 cm	0.91 L/s	14 cm
R-3	RD 2C (RD-100-A-ADJ)	1/4 EXPOSED	0.72 L/s	10 cm	0.82 L/s	11 cm	0.91 L/s	14 cm
R-3	RD 3C (RD-100-A-ADJ)	1/4 EXPOSED	0.72 L/s	10 cm	0.82 L/s	11 cm	0.91 L/s	14 cm
R-3	RD 4C (RD-100-A-ADJ)	1/4 EXPOSED	0.72 L/s	10 cm	0.82 L/s	11 cm	0.91 L/s	14 cm
R-3	RD 5C (RD-100-A-ADJ)	1/4 EXPOSED	0.66 L/s	6 cm	0.69 L/s	7 cm	0.82 L/s	11 cm

SITE FLOWS & STORMWATER MANAGEMENT TABLE

DESIGN EVENT	PRE-DEVELOPMENT CONDITIONS		POST-DEVELOPMENT CONDITIONS						REDUCTION IN FLOW (L/s or %)	
	UNCONTROLLED FLOW (L/s)	ALLOWABLE RELEASE RATE (L/s)*	A-1 DIRECT RUNOFF (L/s)	A-2 FLOW (L/s)	A-3 FLOW (L/s)	R-1 FLOW (L/s)	R-2 FLOW (L/s)	R-3 FLOW (L/s)		TOTAL FLOW (L/s)
1.2 YR	63.3	63.3	26.5	13.5	3.7	2.9	2.9	3.5	52.9	10.4 or 16%
1.5 YR	85.9	85.9	35.9	16.8	5.0	3.3	3.3	4.0	68.2	17.7 or 12%
1.100 YR	184.0	184.0	71.9	24.3	9.4	3.6	3.6	4.5	117.3	66.7 or 36%

AREA A-2: ICD TABLE - CBMH 104

DESIGN EVENT	TYPE OF ICD	DIAMETER OF OUTLET PIPE (mm)	DESIGN FLOW (L/s)	DESIGN HEAD (m)	WATER DEPTH (m)	VOLUME (m³)
1.2 YR	118mm DIA. ORIFICE	375	13.5	0.20	84.82	84.8
1.5 YR	PLUG TYPE ICD		16.8	0.31	84.93	116.4
1.100 YR			24.3	0.65	85.27	242.9

CONNECTION TO EXISTING 300mmØ WATERMAIN BY CITY FORCES. EXACT ELEVATION TO BE FIELD DETERMINED.

CRITICAL SEWER PIPE CROSSING TABLE

CROSSING	LOWER PIPE	HIGHER PIPE	CLEARANCE	SURFACE ELEVATION
1	250mmØ TWM-83.95	300mmØ STM INV-84.81 ± 0.1m	± 0.1m	86.55 m
2	250mmØ TWM-84.20	375mmØ STM INV-84.81 ± 0.5m	± 0.5m	86.60 m
3	250mmØ TWM-84.10	375mmØ STM INV-84.64 ± 0.54m	± 0.54m	86.60 m
4	250mmØ TWM-83.90	375mmØ STM INV-84.43 ± 0.53m	± 0.53m	86.85 m
5	200mmØ TWM-84.27	375mmØ STM INV-84.97 ± 0.70m	± 0.70m	86.67 m
6	230mmØ STM INV-84.27	375mmØ STM INV-84.94 ± 0.67m	± 0.67m	86.67 m
7	200mmØ SAN OVB-84.2	375mmØ STM INV-85.03 ± 2.61m	± 2.61m	86.77 m

Recommended Light Weight Fill

- Minimum 0.2 m thick EPS LWF
- Minimum 0.4 m thick EPS LWF
- Minimum 0.5 m thick EPS LWF

Note: EPS 15 LWF should be placed above the service pipes and surrounded by non-woven geotextile.

Service Pipe




EPS 15 LWF

OPSS Granular A

Service Pipe

OPSS Granular A

Native Subgrade

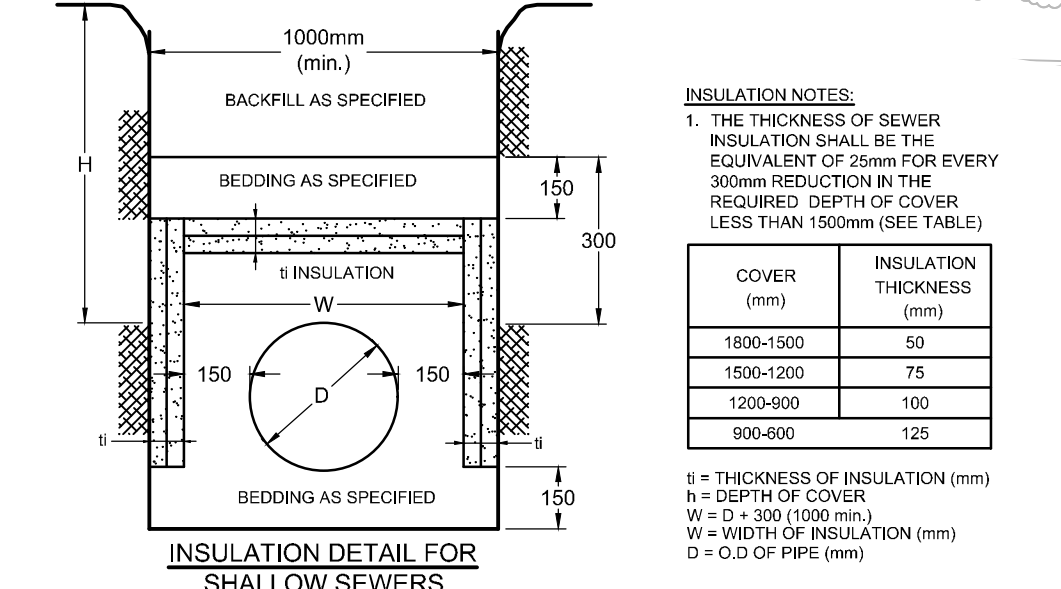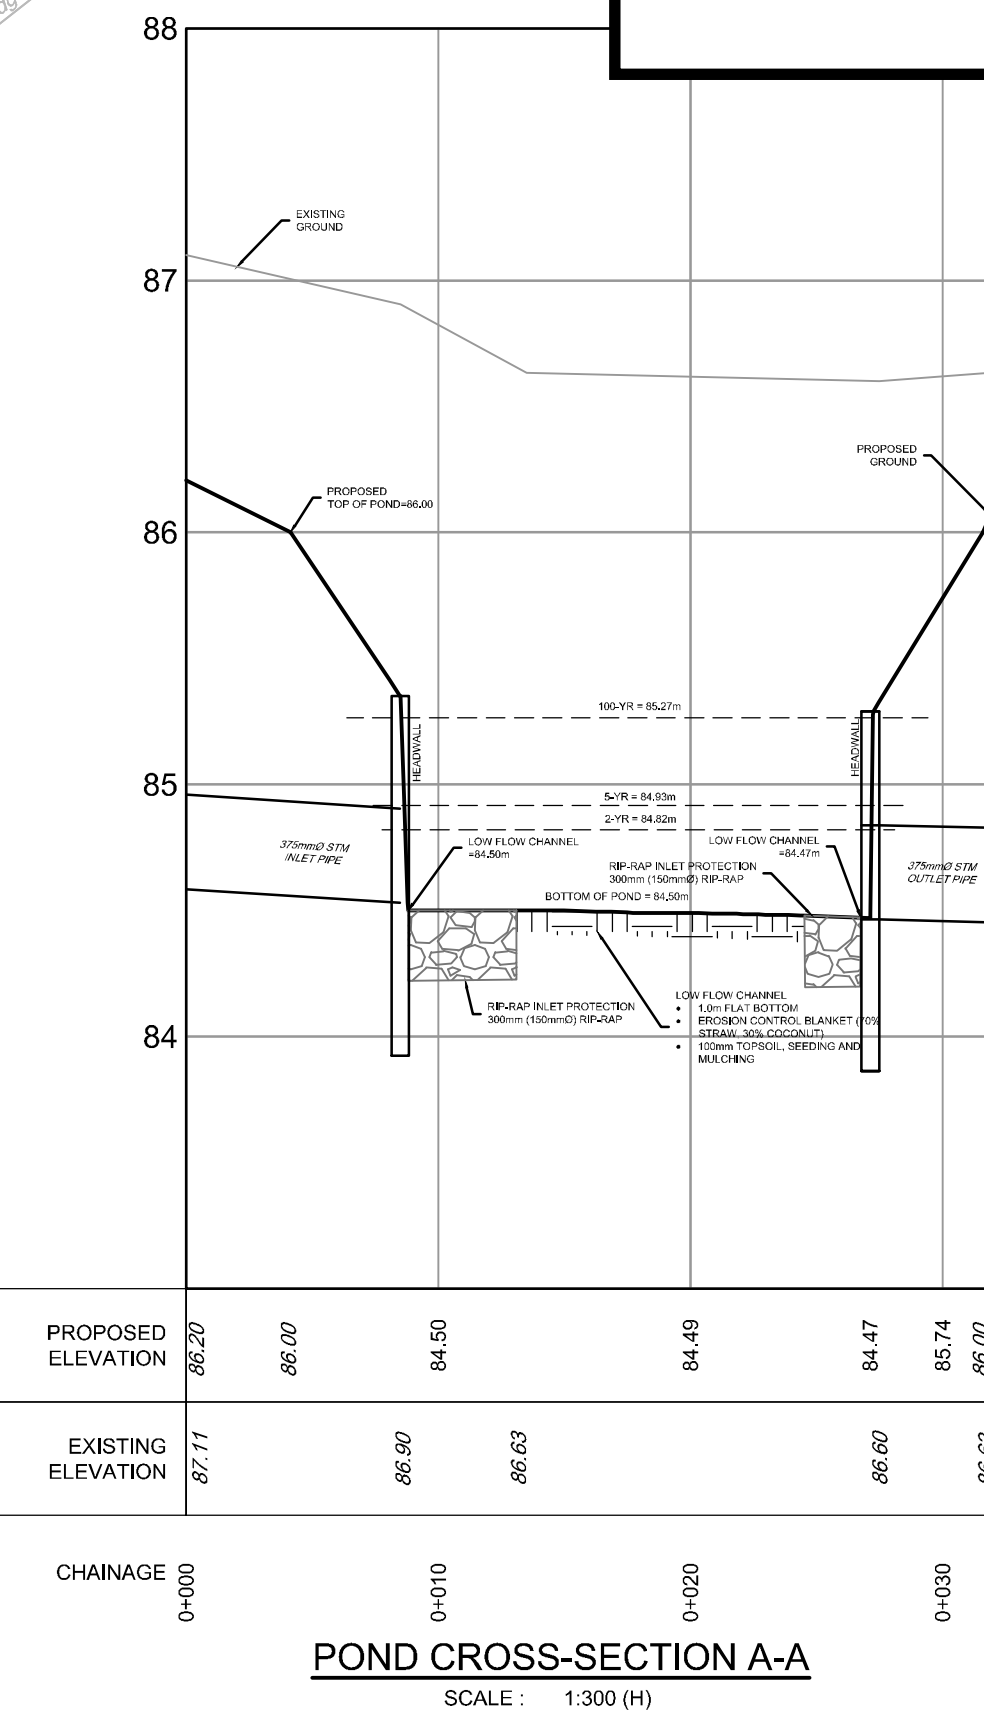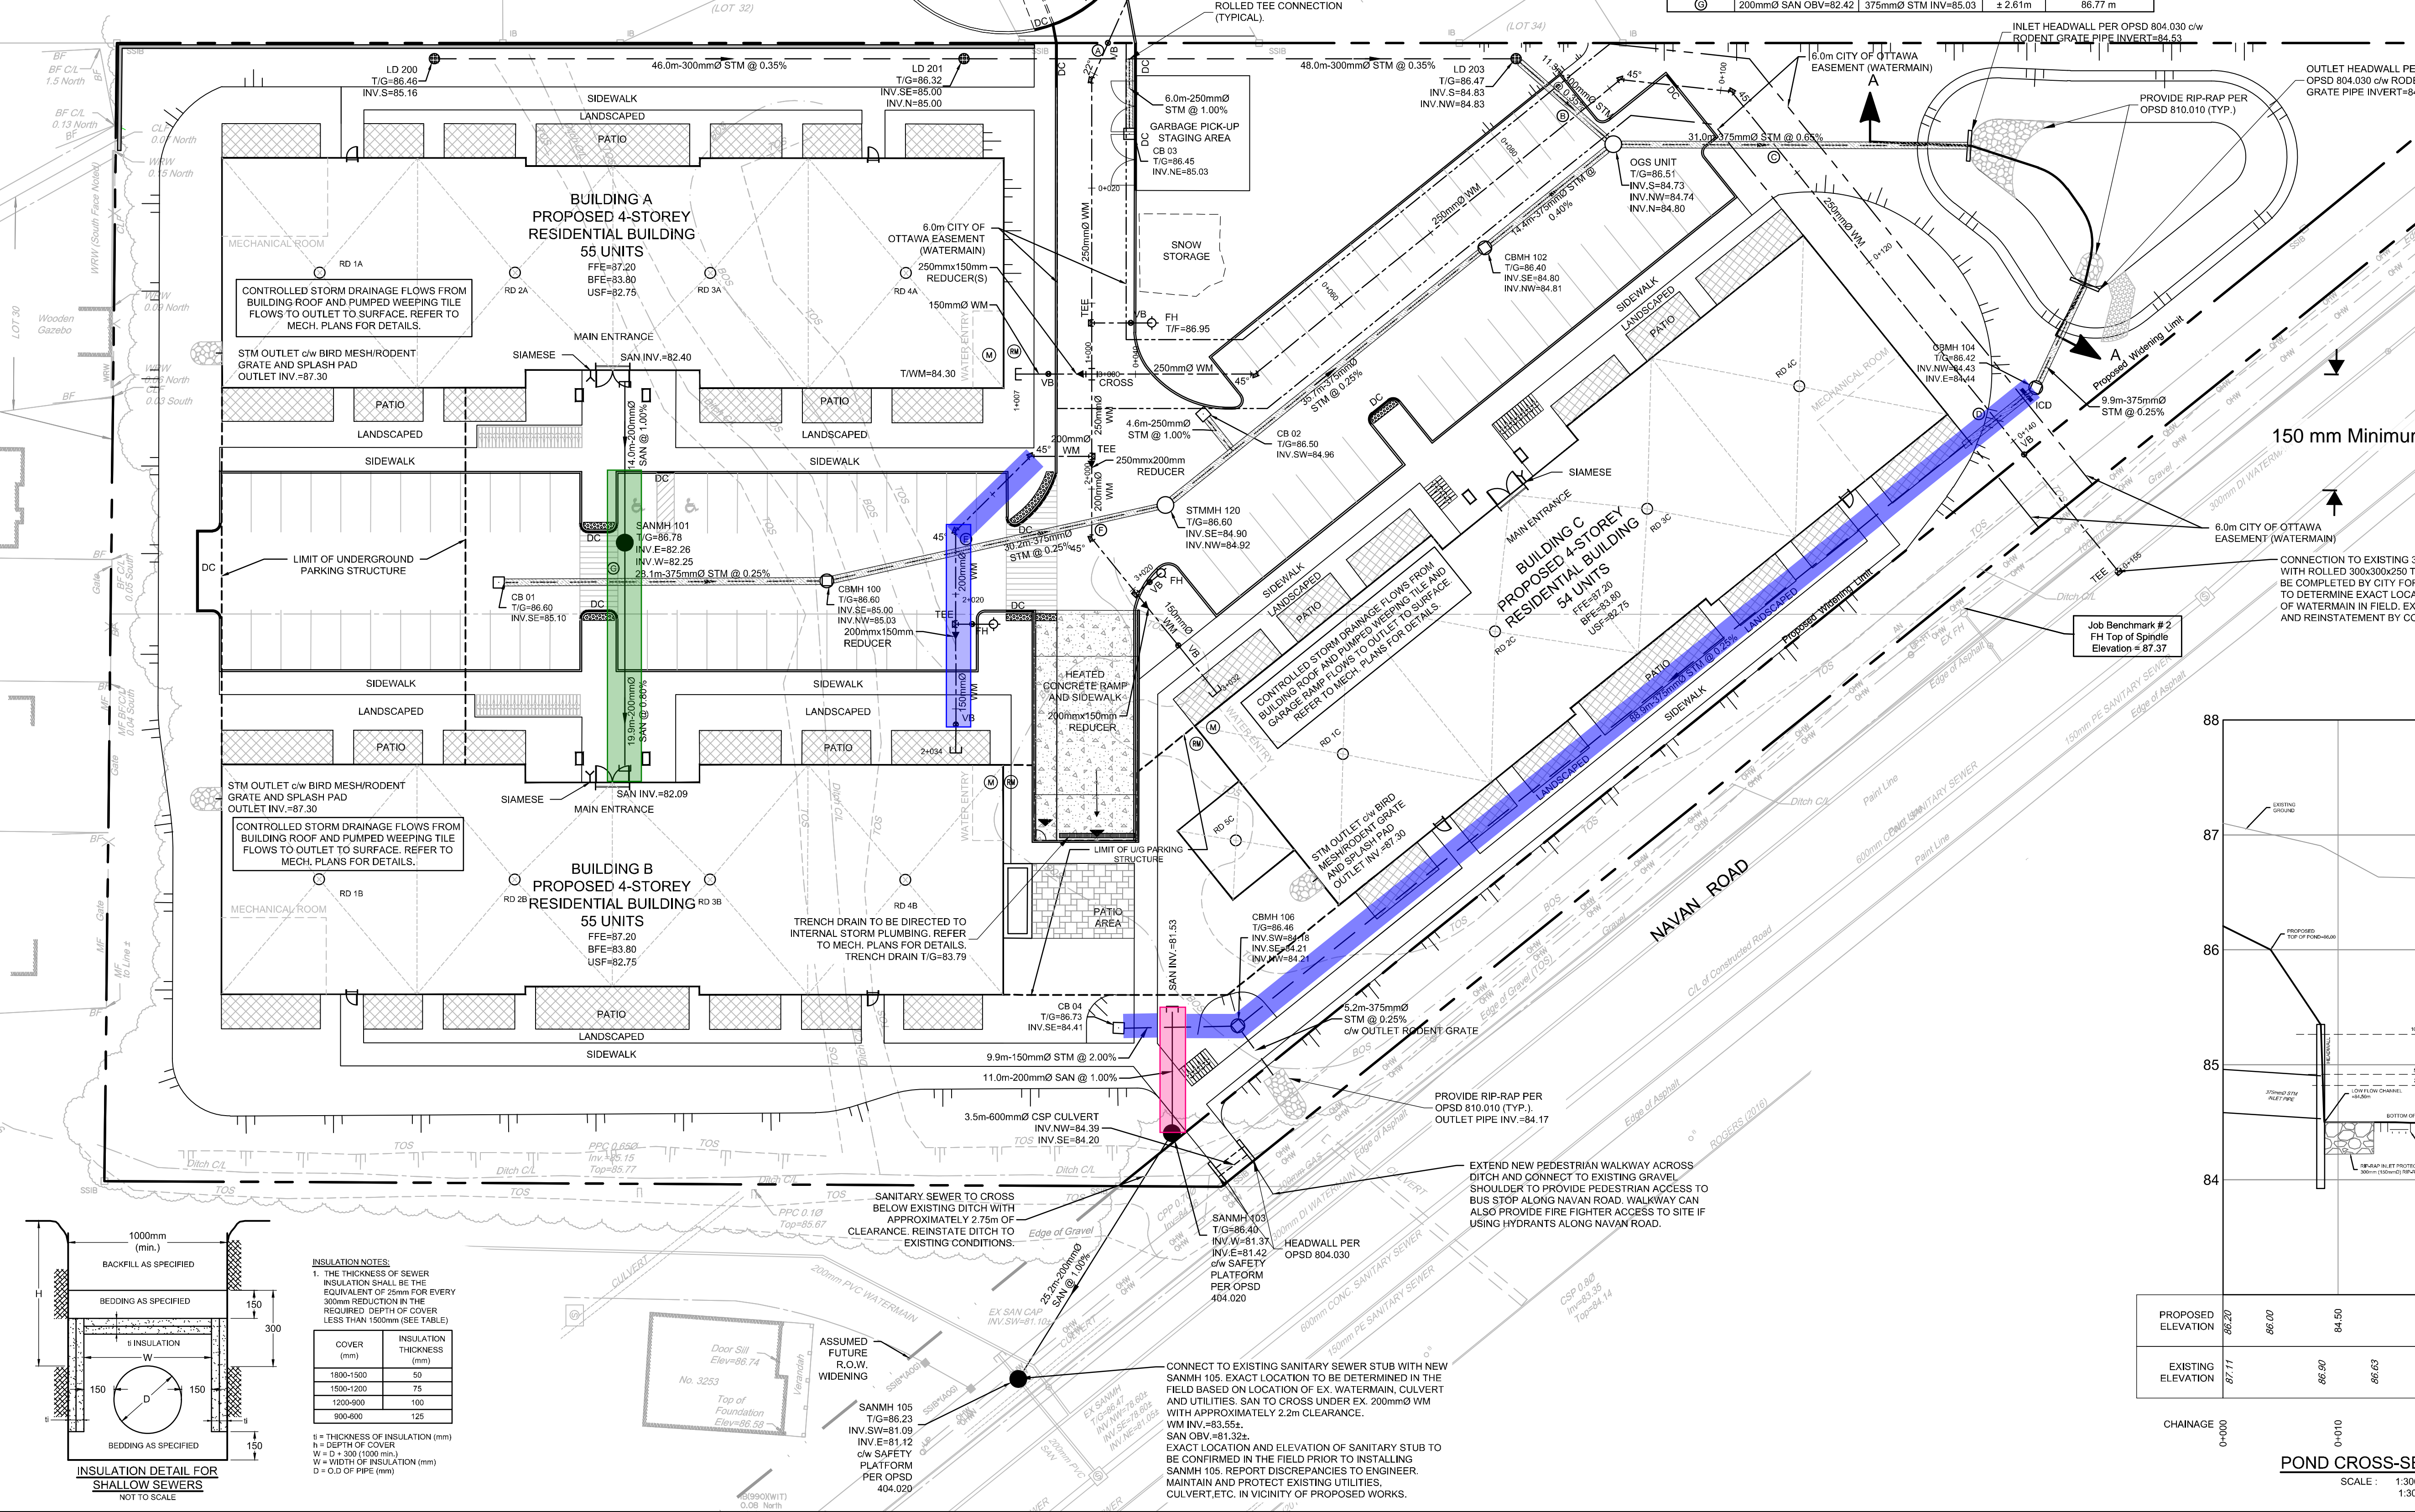

INSULATION NOTES

- THE THICKNESS OF SEWER INSULATION SHALL BE THE EQUIVALENT OF 25mm FOR EVERY 30mm REDUCTION IN THE REQUIRED DEPTH OF COVER (LESS THAN 1500mm (SEE TABLE))

COVER (mm)	INSULATION THICKNESS (mm)
1000-1500	50
1500-2000	75
2000-2500	100
2500-3000	125

± THICKNESS OF INSULATION (mm) = 1/30TH OF COVER

W = WIDTH OF INSULATION (mm)

D = O.D. OF PIPE (mm)

- WATERMAIN NOTES:**
- ALL STORM MANHOLES AND CATCHBASIN MANHOLES ARE TO HAVE 300mm SUMPS UNLESS OTHERWISE INDICATED. ALL CATCHBASINS ARE TO HAVE 600mm SUMPS UNLESS OTHERWISE INDICATED.
 - ALL CATCHBASINS, MANHOLES AND/OR CATCHBASIN MANHOLES THAT ARE TO HAVE ICD'S INSTALLED WITHIN THEM ARE TO HAVE 600mm SUMPS.
 - ALL WEeping TILE CONNECTIONS TO BE MADE TO THE PROPOSED STORM SEWER SYSTEM DOWNSTREAM OF ANY INLET CONTROL DEVICES.
 - CONTRACTOR TO TELEVIEW (CCTV) ALL PROPOSED SEWERS, 200mmØ OR GREATER PRIOR TO BASE COURSE ASPHALT. UPON COMPLETION OF SECTION OF CONTRACT, THE CONTRACTOR IS RESPONSIBLE TO FLUSH AND CLEAN ALL SEWERS & APPURTENANCES.
- WATERMAIN NOTES:**
- SUPPLY AND CONSTRUCT ALL WATERMANS AND APPURTENANCES IN ACCORDANCE WITH THE CITY OF OTTAWA STANDARDS AND SPECIFICATIONS. EDUCATION, INSTALLATION, BACKFILL AND RESTORATION OF ALL WATERMANS BY THE CONTRACTOR. CONNECTIONS, SHUT-OFFS AT THE MAIN AND CHLORINATION OF THE WATER SYSTEM SHALL BE PERFORMED BY CITY OF OTTAWA FORCES.
 - SPECIFICATIONS:
- | ITEM | SPEC. NO. | REFERENCE |
|--|-----------|----------------|
| WATERMAIN TRENCHING | W17 | CITY OF OTTAWA |
| FIRE HYDRANT INSTALLATION | W19 | CITY OF OTTAWA |
| THERMAL INSULATION IN SHALLOW TRENCHES | W22 | CITY OF OTTAWA |
| INSULATION ADJACENT TO OPEN STRUCTURES | W23 | CITY OF OTTAWA |
| VALVE BOX ASSEMBLY | W24 | CITY OF OTTAWA |
| WATERMAIN | PVC DR 18 | CITY OF OTTAWA |
| WATERMAIN CROSSING BELOW SEWER | W25 | CITY OF OTTAWA |
| WATERMAIN CROSSING ABOVE SEWER | W25.2 | CITY OF OTTAWA |
- WATERMAIN SHALL BE MINIMUM 2.4m DEPTH BELOW GRADE UNLESS OTHERWISE INDICATED.
 - PROVIDE MINIMUM 0.5m CLEARANCE BETWEEN OUTSIDE OF PIPES AT ALL CROSSINGS, IF SEWER IS ABOVE WATERMAIN.
 - PROPOSED WATER SERVICES ARE TO BE CONSTRUCTED TO WITHIN 1.0m OF FOUNDATION WALL AND CAPPED, UNLESS OTHERWISE INDICATED.
- BENCHMARK NOTES:**
- ELEVATIONS SHOWN ARE GEODETIC AND ARE REFERRED TO THE CDVD93 GEODETIC DATUM, DERIVED FROM CONTROL MONUMENT NO. 00119530227 HAVING AN ELEVATION OF 86.707 METRES.
 - IT IS THE RESPONSIBILITY OF THE USER OF THIS INFORMATION TO VERIFY THAT THE JOB BENCHMARK HAS NOT BEEN ALTERED OR DISTURBED AND THAT ITS RELATIVE ELEVATION AND DESCRIPTION AGREES WITH THE INFORMATION SHOWN ON THIS DRAWING.
 - BENCHMARK WAS PROVIDED ON TOPOGRAPHIC PLAN OF SURVEY OF PART OF LOT 4, CONVESSION 4 (OTTAWA FRONT) GEOGRAPHIC TOWNSHIP OF GLOUCESTER, CITY OF OTTAWA, SURVEYED BY ANNIS, O'SULLIVAN AND VOLEBEK LTD.

OWNER INFORMATION

262576 ONTARIO INC.
231 BRITANNY DRIVE, SUITE D
OTTAWA, ONTARIO, K1K 0R8
LALIT AGGARWAL
PHONE: (613)-746-1647
lsa@manorparkcap.com

SCALE

1:300

FOR REVIEW ONLY

No.	REVISION	DATE	BY
3	REVISED PER CITY COMMENTS	FEB 14/24	FST
2	REVISED PER CITY COMMENTS	NOV 13/23	FST
1	ISSUED FOR SITE PLAN CONTROL APPROVAL	JUNE 8/23	FST

LOCATION

CITY OF OTTAWA
3317 NAVAN ROAD

DRAWING NAME

GENERAL PLAN OF SERVICES

NOVATECH
Engineers, Planners & Landscape Architects
Suite 200, 240 Michael Cowland Drive
Ottawa, Ontario, Canada K2M 1P6
Telephone: (613) 254-9643
Facsimile: (613) 254-5867
Website: www.novatech-eng.com


PROFESSIONAL ENGINEER
F.S. THALLETTE
1000415390
February 14, 2024


PROJECT NO. 118076
REV #3
DRAWING NO. 118076-GP
Plan #19008

D07-12-23-0085

NOTES:

1. USE EPS 15 AROUND THE BUILDING AND UNDER PAVEMENT STRUCTURES
2. USE EPS 12 BELOW SOFT LANDSCAPED AREAS AND MINIMUM 500 MM OF APPROVED BACKFILL TOPPED WITH A MINIMUM OF 150 MM OF TOPSOIL SHOULD BE PLACED OVER THE LWF UNDER SOFT LANDSCAPED AREAS.
3. MINIMUM 300mm OF OPSS GRANULAR A SHOULD BE PLACED OVER THE LIGHTWEIGHT FILL UNDER PAVEMENT STRUCTURES AND OTHER PARKING STRUCTURES.
4. PLACEMENT OF LIGHTWEIGHT FILL SHOULD BE A ON A LEVELED SURFACE.(SAND OR STONE DUST CAN BE USED TO PROVIDE AND ADEQUATE LEVELING SURFACE)

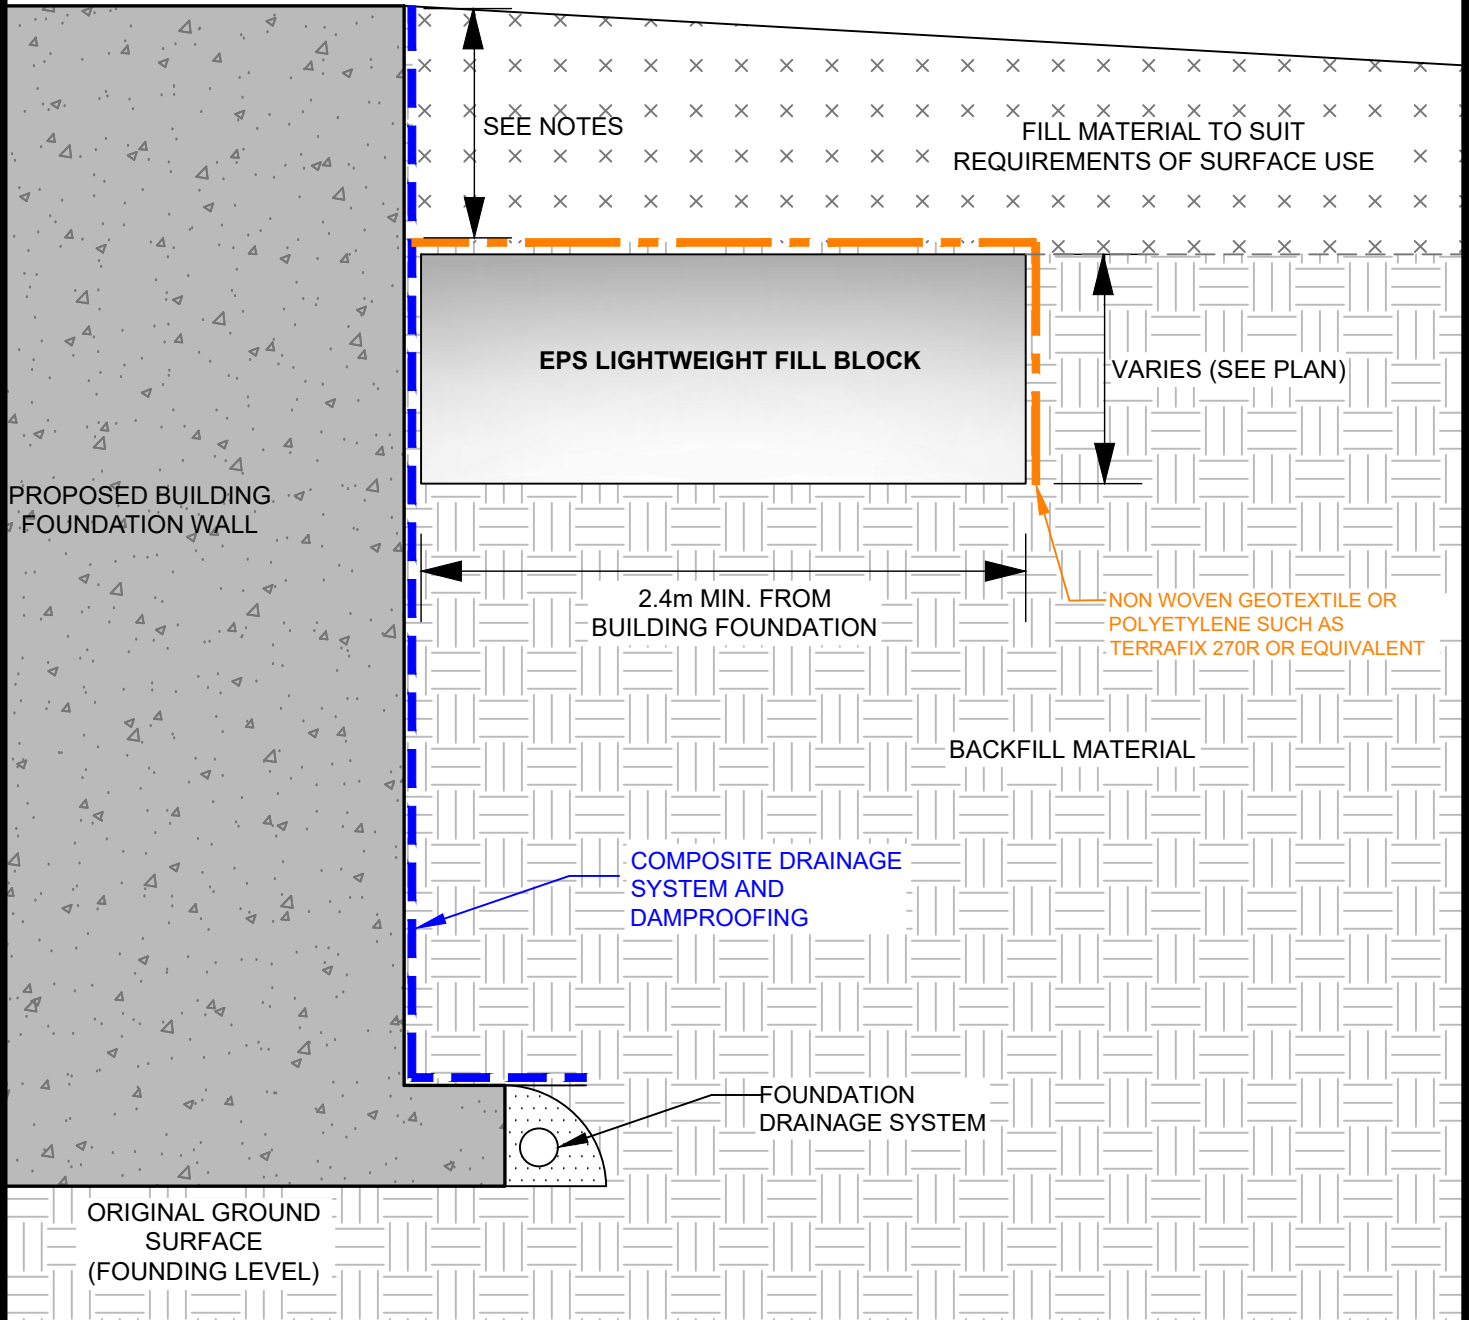

 <p>9 AURIGA DRIVE OTTAWA, ON K2E 7T9 TEL: (613) 226-7381</p>	RENFROE LAND MANAGEMENT PROPOSED RESIDENTIAL DEVELOPMENT 3317 NAVAN ROAD, OTTAWA ONTARIO		Date: 02/2024	Report No.: PG6582-MEMO.04
	EPS BLOCK INSTALLATION AROUND RESIDENTIAL BUILDINGS		Scale: 1:30	Drawing No.: FIGURE-1
			Drawn by: PT	Checked by: JV
	Title:			