

# LEGEND

-  EXTERIOR SITE WORKS
-  EVENT CENTRE & NEW NORTH STANDS

CONSTRUCTION ACCESS AND OPERATIONS  
(MARK-UP FROM MEETING 14TH JUNE 2024)

### GENERAL NOTES:

- TEMPORARY FIRE ROUTES NEED TO BE LEVEL
- 250 CARS CAN BE PARKED UNDERGROUND @ \$10 DAY/VEHICLE



**BRISBIN BROOK BEYON ARCHITECTS**  
14 DUNCAN ST 4TH FLOOR  
TORONTO, ON M5H 3G8  
(416) 591-8999

**ENTUITIVE**  
135 LAURIER AVE WEST, SUITE 413  
OTTAWA, ON K1P 5J2  
(343) 308-9274

**TMP**  
200 KING ST. WEST, SUITE 310  
TORONTO, ON M5H 3T4  
(416) 499-8000


**MULVEY & BANANI**  
90 SHEPPARD AVE EAST, SUITE 500  
TORONTO, ON M2N 3A  
(416) 751-2520

**S2O**  
530 N. WOOD STREET #C  
CHICAGO, IL 60622  
(224) 717-1999

**C.S.W.**  
319 MCRAE AVE (E) SUITE 502  
OTTAWA, ONTARIO K1Z 0B9  
(613) 738-6336

PRELIMINARY FOR DISCUSSION

REVISIONS/ ISSUES  
CONTRACTOR SHALL CHECK AND VERIFY ALL DIMENSIONS AND REPORT ANY OMISSIONS OR DISCREPANCIES TO THE ARCHITECT BEFORE PROCEEDING WITH THE WORK. DO NOT SCALE THE DRAWINGS

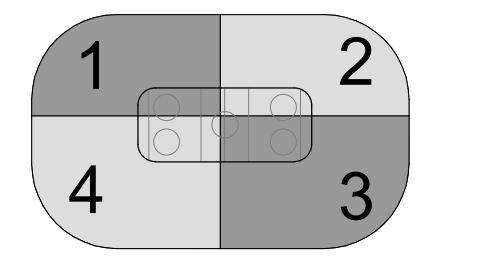

SEAL  
THIS DOCUMENT IS RELEASED FOR THE PURPOSE OF PRELIMINARY SUBMITTAL  
IT IS NOT TO BE USED FOR CONSTRUCTION PURPOSES

DRAWN: JI  
DATE: 01/24/24  
CHECKED: SJ


## LANSDOWNE EVENT CENTRE

DWG. TITLE  
EXTENT OF EVENT CENTRE & NEW NORTH STANDS & EXTERIOR SITE WORKS

SCALE: As indicated  
PROJ. NO.: 2008  
DWG. NO.: A1-008f

DATE PLOTTED: 2024-06-12 11:17:51 AM

EXTENT OF EVENT CENTRE & NEW NORTH STANDS & EXTERIOR SITE WORKS  
1:1000

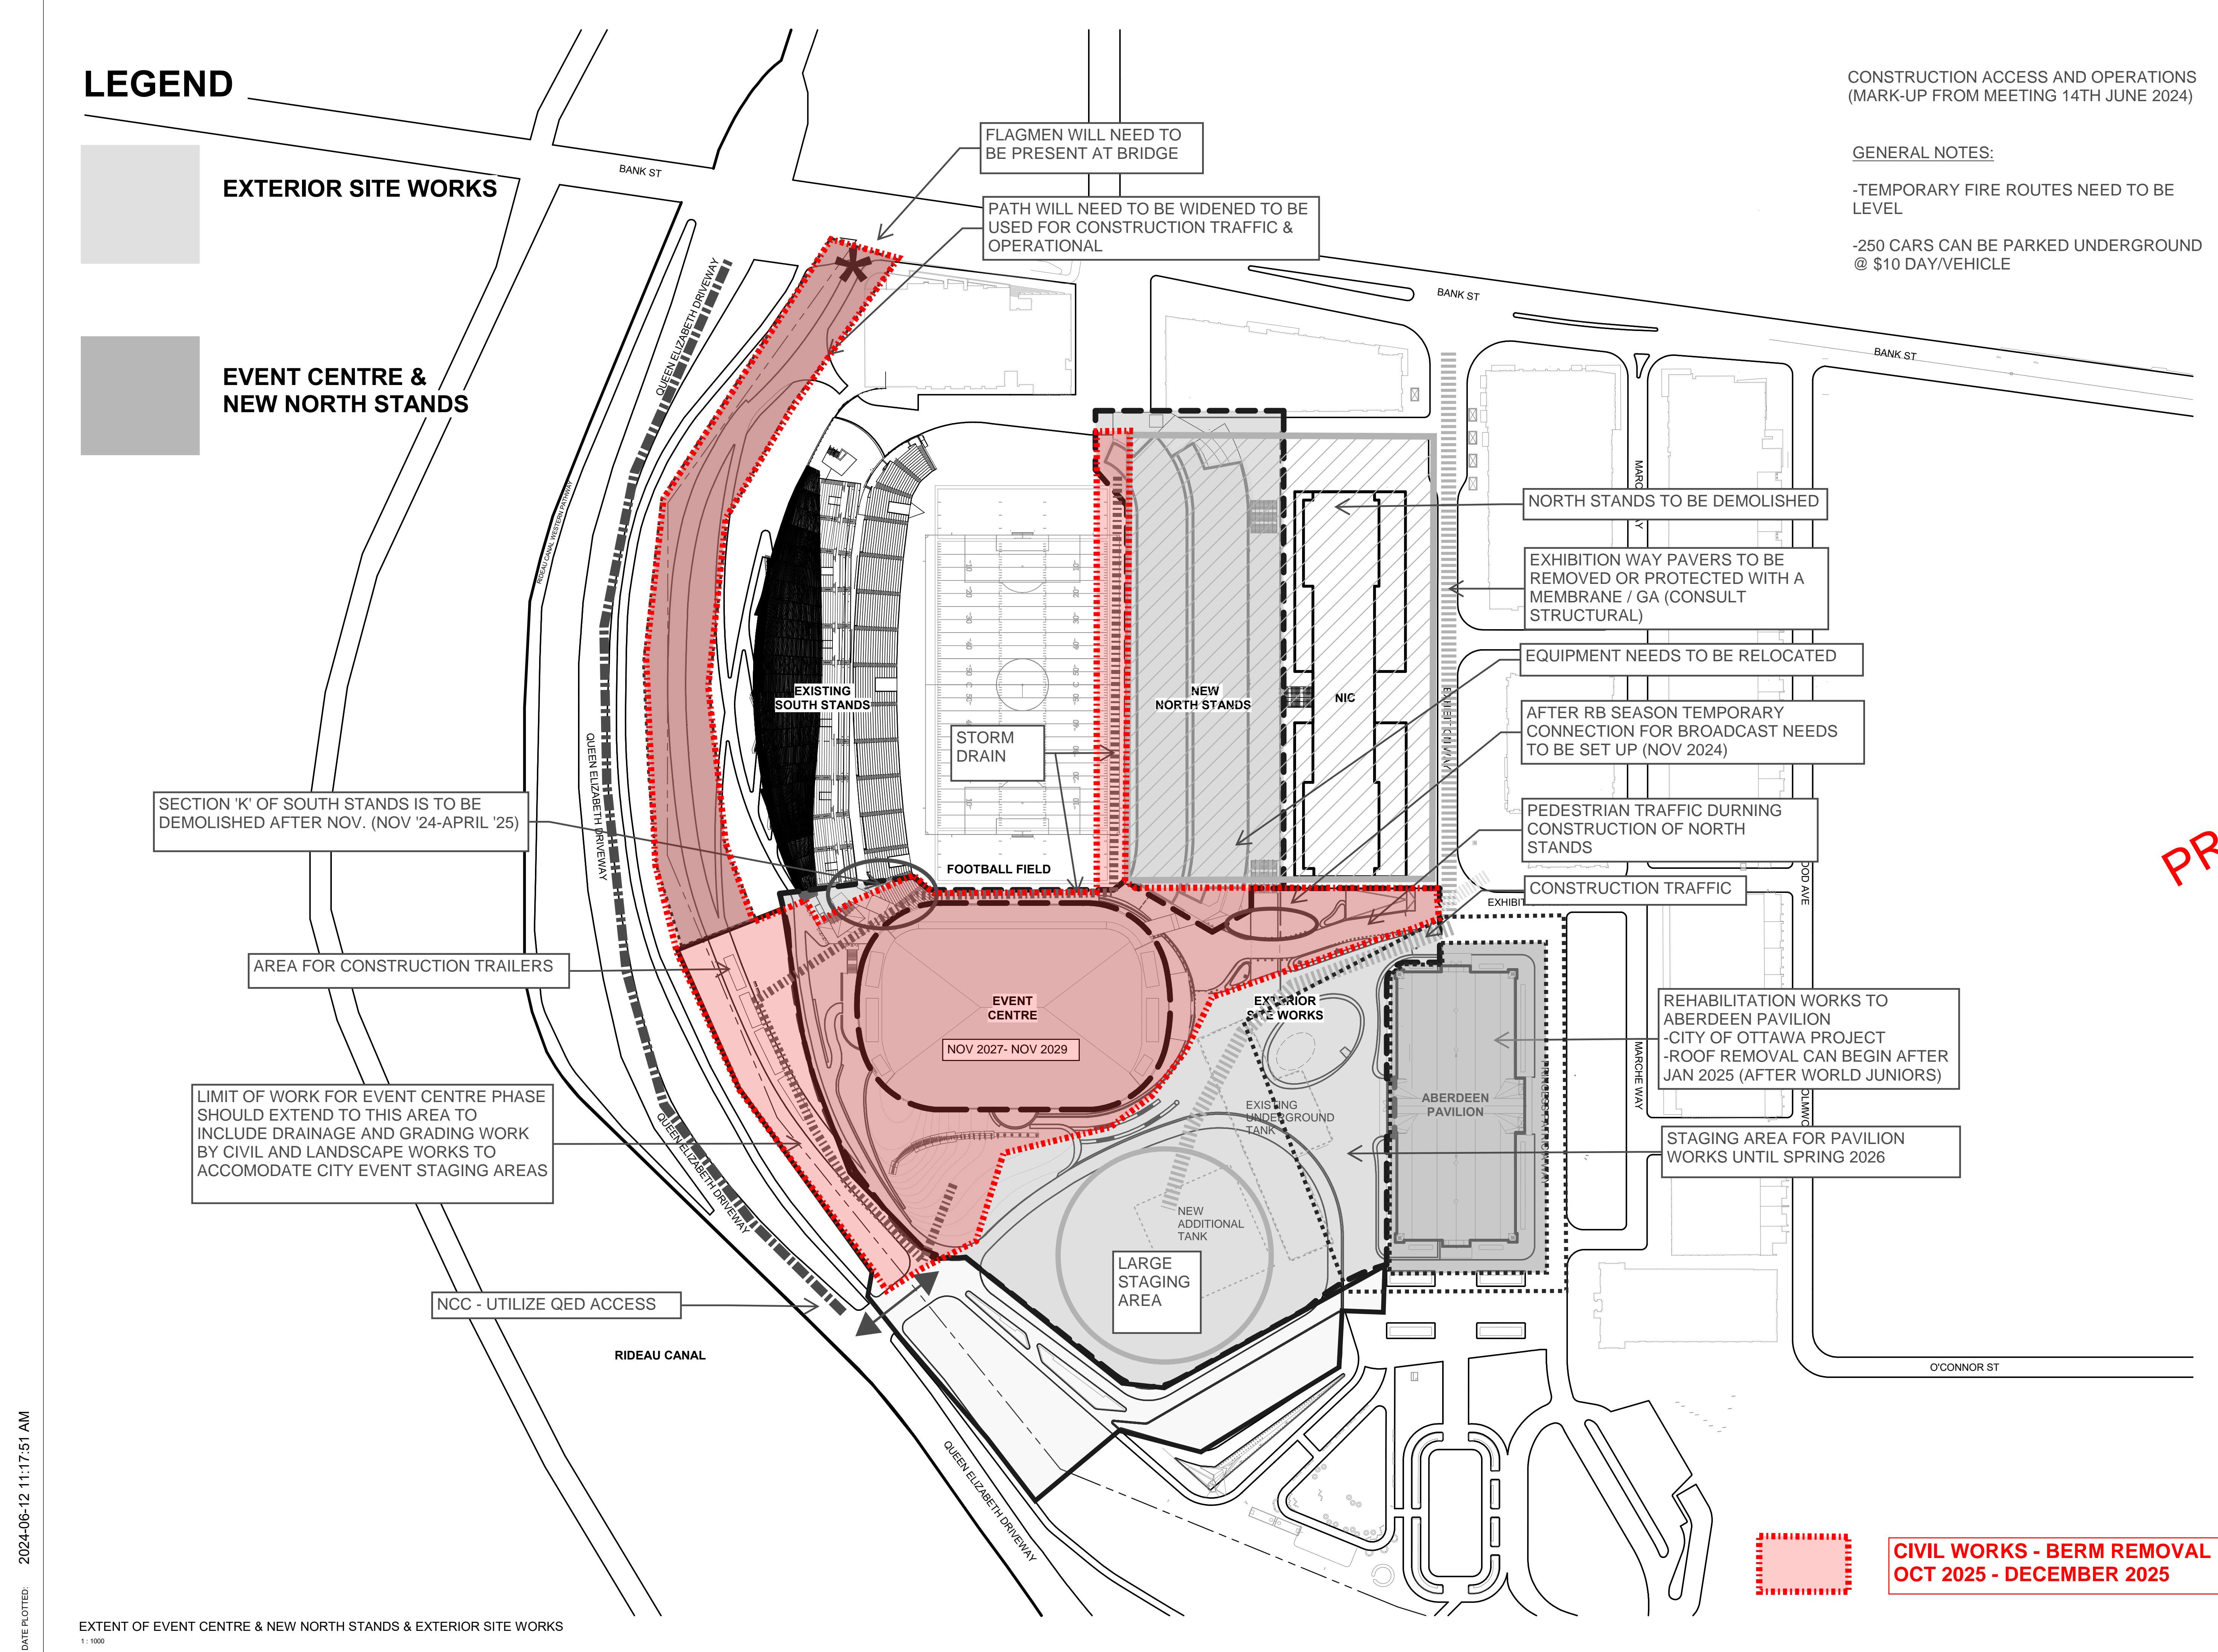

 CIVIL WORKS - BERM REMOVAL  
OCT 2025 - DECEMBER 2025

# LEGEND

-  EXTERIOR SITE WORKS
-  EVENT CENTRE & NEW NORTH STANDS

CONSTRUCTION ACCESS AND OPERATIONS  
(MARK-UP FROM MEETING 14TH JUNE 2024)

**GENERAL NOTES:**

- TEMPORARY FIRE ROUTES NEED TO BE LEVEL
- 250 CARS CAN BE PARKED UNDERGROUND @ \$10 DAY/VEHICLE



**BRISBIN BROOK BEYON ARCHITECTS**  
14 DUNCAN ST 4TH FLOOR  
TORONTO, ON M5H 3G8  
(416) 591-8999

**ENTUITIVE**  
135 LAURIER AVE WEST, SUITE 413  
OTTAWA, ON K1P 5J2  
(343) 308-9274

**TMP**  
200 KING ST. WEST, SUITE 310  
TORONTO, ON M5H 3T4  
(416) 499-8000

**MULVEY & BANANI**  
90 SHEPPARD AVE EAST, SUITE 500  
TORONTO, ON M2N 3A  
(416) 751-2520


**S2O**  
530 N. WOOD STREET #C  
CHICAGO, IL 60622  
(224) 717-1999

**C.S.W.**  
319 MCRAE AVENUE, SUITE 502  
OTTAWA, ONTARIO K1Z 0B9  
(613) 729-4536

PRELIMINARY FOR DISCUSSION

NO.	DATE	REVISIONS/ ISSUES

CONTRACTOR SHALL CHECK AND VERIFY ALL DIMENSIONS AND REPORT ANY OMISSIONS OR DISCREPANCIES TO THE ARCHITECT BEFORE PROCEEDING WITH THE WORK. DO NOT SCALE THE DRAWINGS

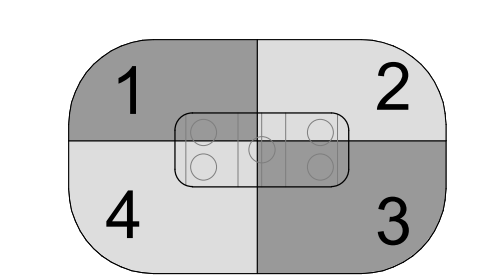

SEAL  
THIS DOCUMENT IS RELEASED FOR THE PURPOSE OF PRELIMINARY SUBMITTAL  
IT IS NOT TO BE USED FOR CONSTRUCTION PURPOSES

DRAWN	JJ
DATE	01/24/24
CHECKED	SJ


## LANSDOWNE EVENT CENTRE

DWG. TITLE  
EXTENT OF EVENT CENTRE & NEW NORTH STANDS & EXTERIOR SITE WORKS

SCALE	As indicated	DWG. NO.	A1-008f
PROJ. NO.	2008		

DATE PLOTTED: 2024-06-12 11:17:51 AM

EVENT CENTRE CONSTRUCTION  
DEC 2025 - NOV 2027

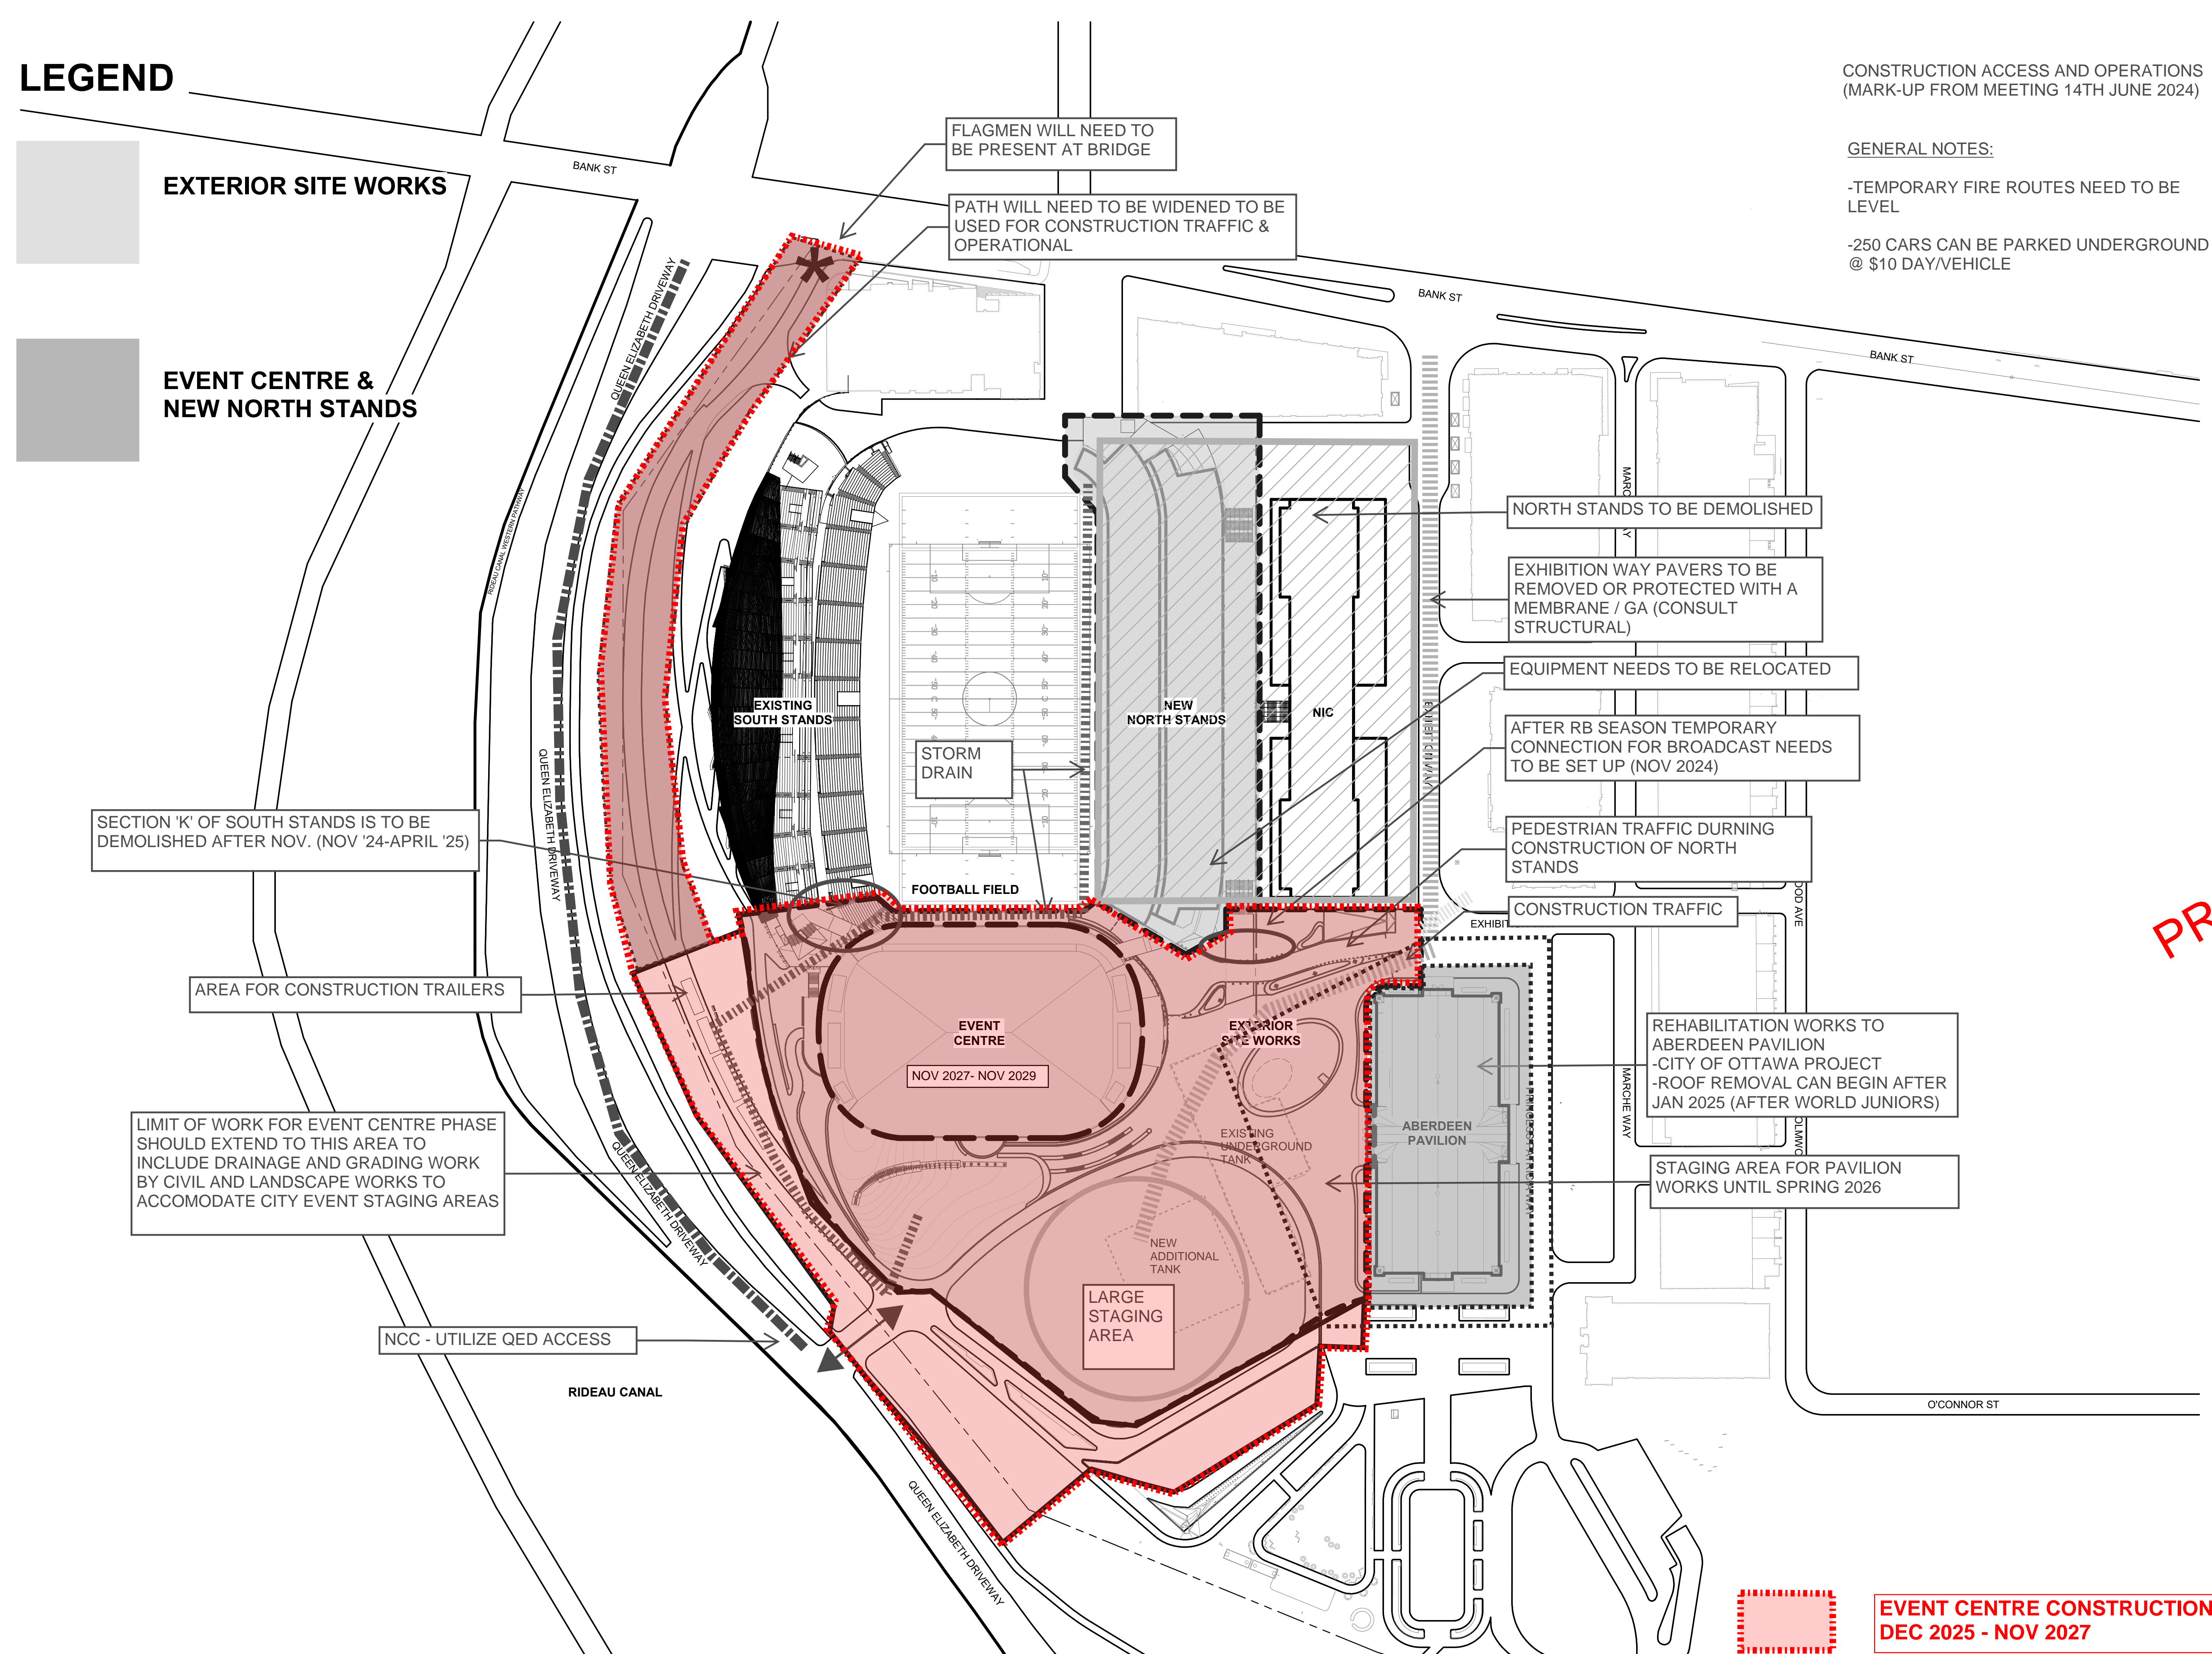

# LEGEND

-  EXTERIOR SITE WORKS
-  EVENT CENTRE & NEW NORTH STANDS

CONSTRUCTION ACCESS AND OPERATIONS  
(MARK-UP FROM MEETING 14TH JUNE 2024)

**GENERAL NOTES:**

- TEMPORARY FIRE ROUTES NEED TO BE LEVEL
- 250 CARS CAN BE PARKED UNDERGROUND @ \$10 DAY/VEHICLE



**BRISBIN BROOK BEYOND ARCHITECTS**  
14 DUNCAN ST 4TH FLOOR  
TORONTO, ON M5H 3G8  
(416) 591-8999

**ENTUITIVE**  
135 LAURIER AVE WEST, SUITE 413  
OTTAWA, ON K1P 5J2  
(343) 308-9274

**TMP**  
200 KING ST. WEST, SUITE 310  
TORONTO, ON M5H 3T4  
(416) 499-8000


**MULVEY & BANANI**  
90 SHEPPARD AVE EAST, SUITE 500  
TORONTO, ON M2N 3A  
(416) 751-2520

**S2O**  
530 N. WOOD STREET #C  
CHICAGO, IL 60622  
(224) 717-1999

**C.S.W.**  
319 MCRAE AVENUE, SUITE 502  
OTTAWA, ONTARIO K1Z 0B9  
(613) 729-4536

PRELIMINARY FOR DISCUSSION

NO.	DESCRIPTION	DATE
REVISIONS/ ISSUES		
CONFIRMATION: SHALL CHECK AND VERIFY ALL DIMENSIONS AND NOTATIONS FOR ANY OMISSIONS OR DISCREPANCIES TO THE ARCHITECT BEFORE PROCEEDING WITH THE WORK. DO NOT SCALE THE DRAWINGS.		

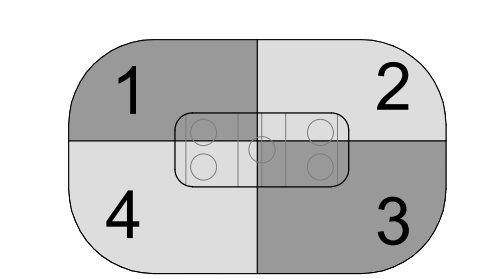

SEAL

THIS DOCUMENT IS RELEASED FOR THE PURPOSE OF PRELIMINARY SUBMITTAL

IT IS NOT TO BE USED FOR CONSTRUCTION PURPOSES

DRAWN	JJ
DATE	01/24/24
CHECKED	SJ


**LANSDOWNE EVENT CENTRE**

DWG. TITLE  
EXTENT OF EVENT CENTRE & NEW NORTH STANDS & EXTERIOR SITE WORKS

SCALE	As indicated	DWG. NO.	A1-008f
PROJ. NO.	2008		

DATE PLOTTED: 2024-06-12 11:17:51 AM

EXTENT OF EVENT CENTRE & NEW NORTH STANDS & EXTERIOR SITE WORKS  
1:1000

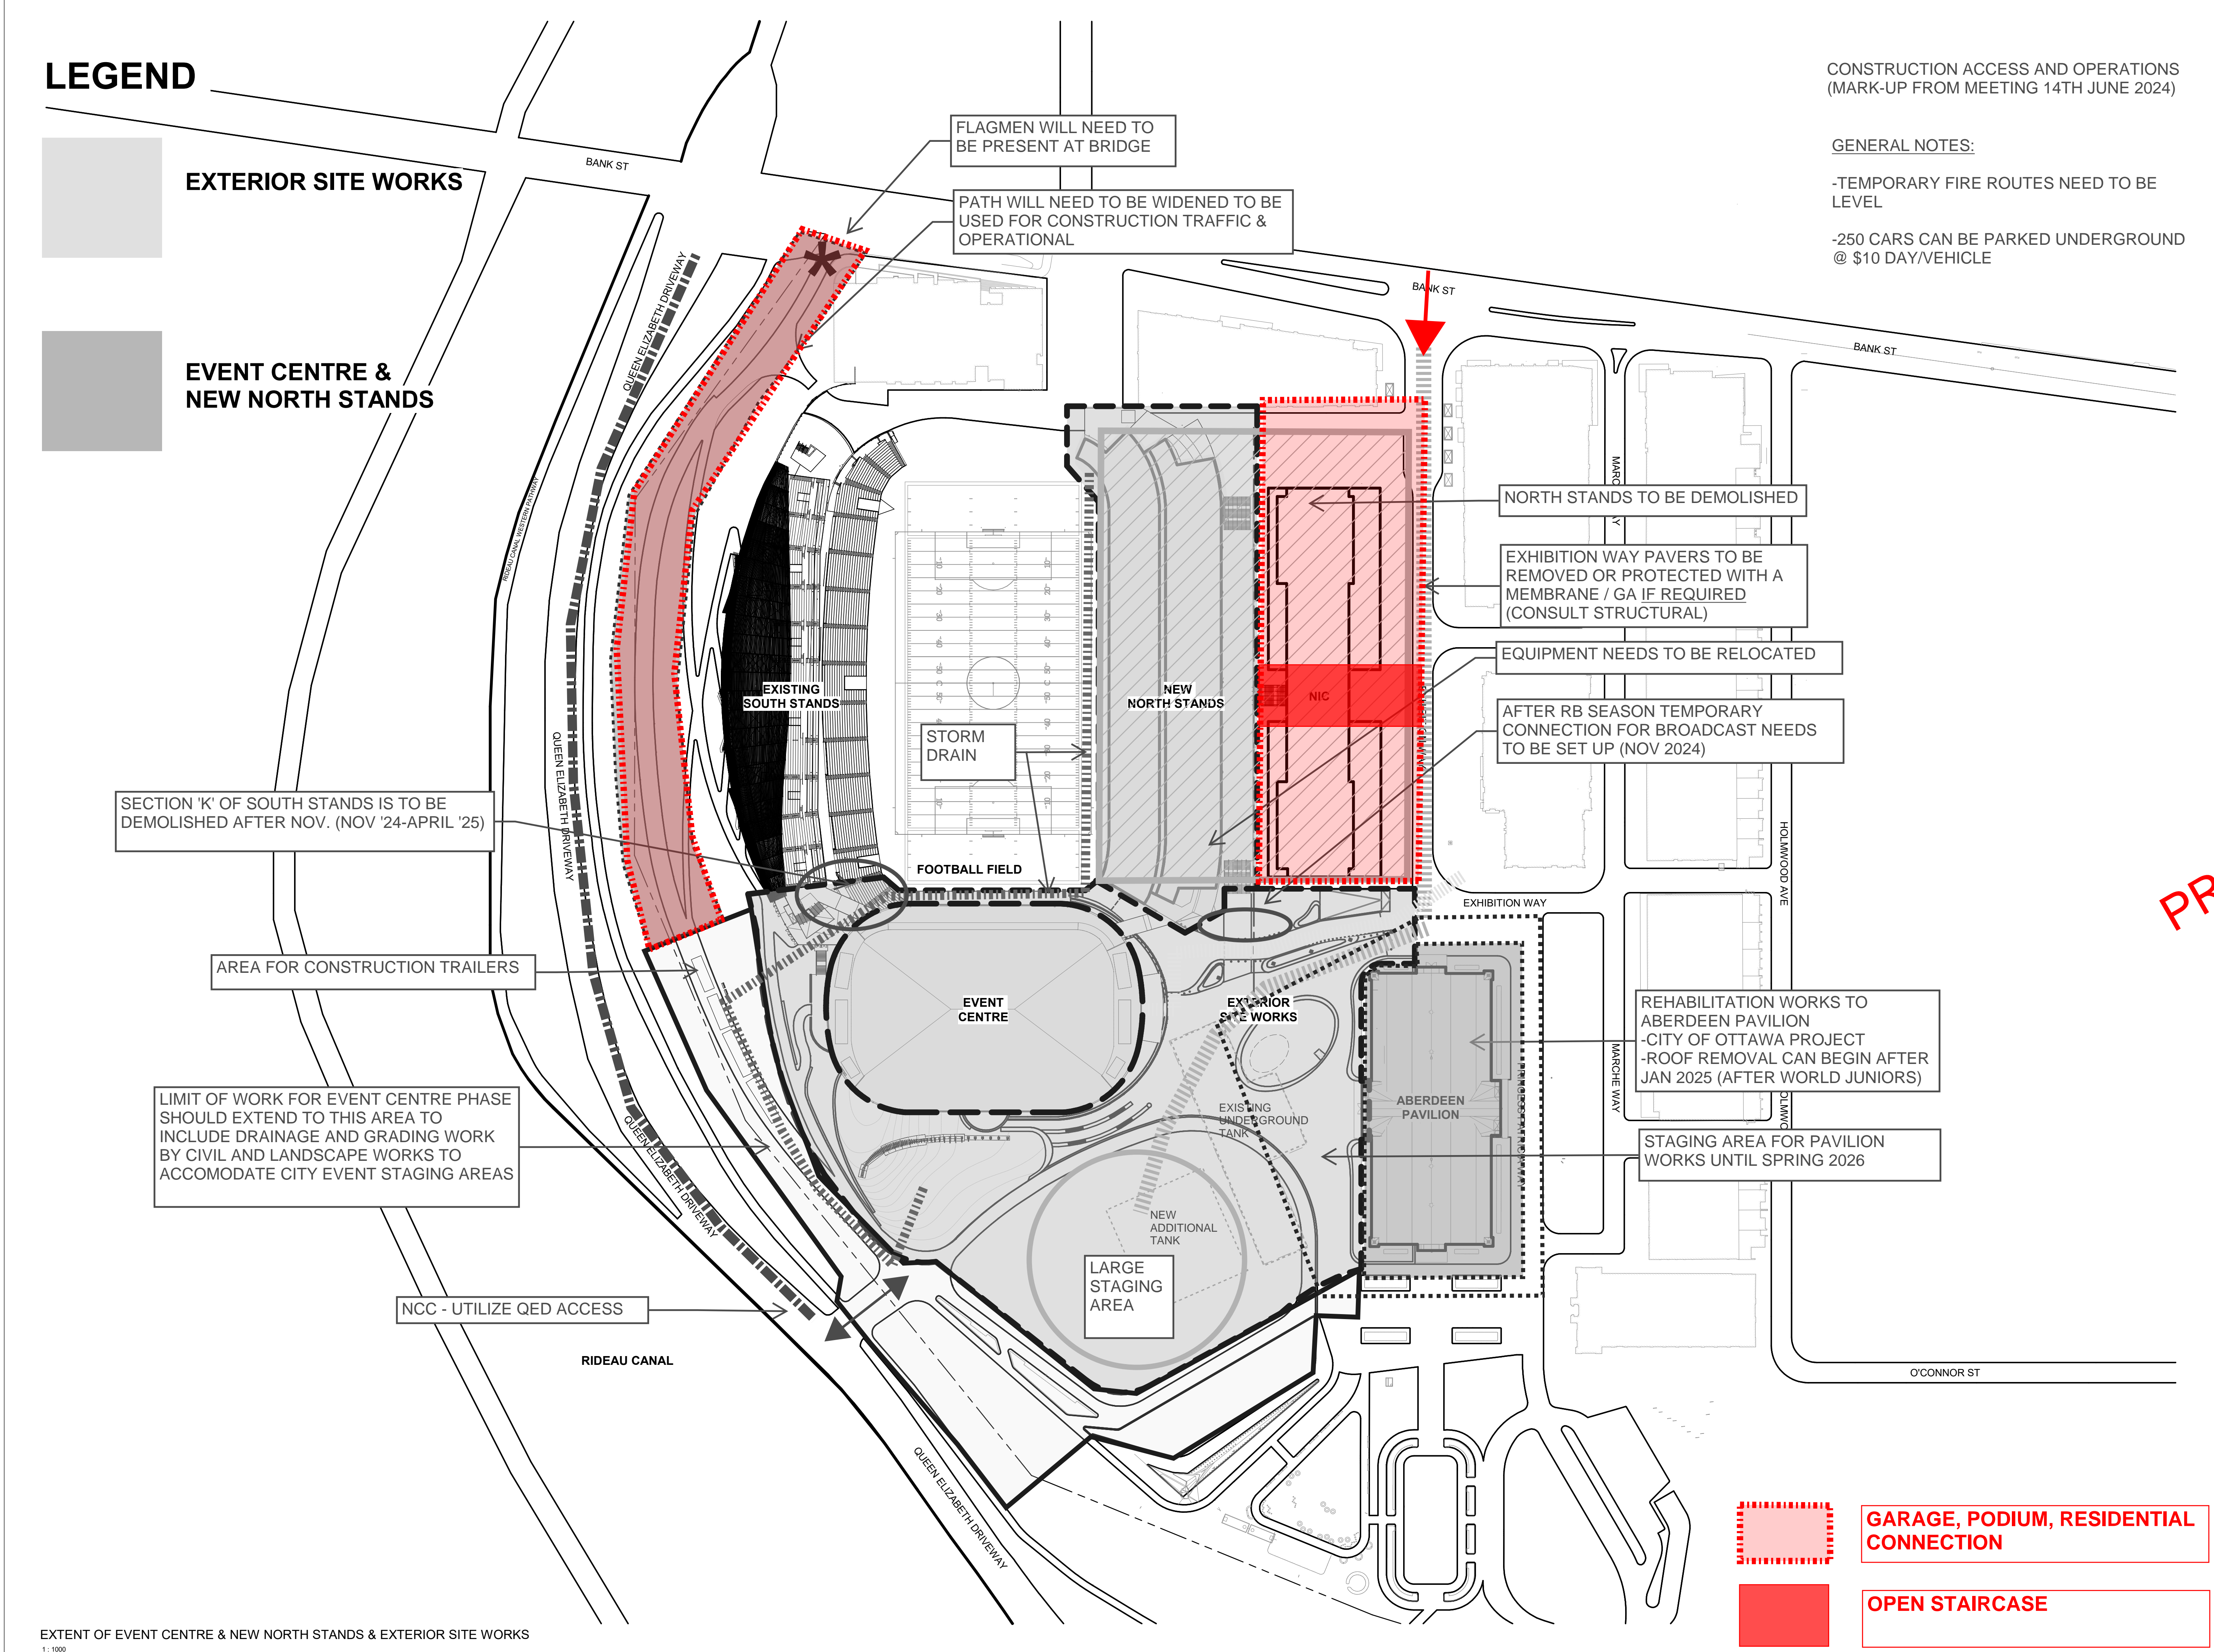

FLAGMEN WILL NEED TO BE PRESENT AT BRIDGE

PATH WILL NEED TO BE WIDENED TO BE USED FOR CONSTRUCTION TRAFFIC & OPERATIONAL

NORTH STANDS TO BE DEMOLISHED

EXHIBITION WAY PAVERS TO BE REMOVED OR PROTECTED WITH A MEMBRANE / GA IF REQUIRED (CONSULT STRUCTURAL)

EQUIPMENT NEEDS TO BE RELOCATED

AFTER RB SEASON TEMPORARY CONNECTION FOR BROADCAST NEEDS TO BE SET UP (NOV 2024)

REHABILITATION WORKS TO ABERDEEN PAVILION  
-CITY OF OTTAWA PROJECT  
-ROOF REMOVAL CAN BEGIN AFTER JAN 2025 (AFTER WORLD JUNIORS)

STAGING AREA FOR PAVILION WORKS UNTIL SPRING 2026

SECTION 'K' OF SOUTH STANDS IS TO BE DEMOLISHED AFTER NOV. (NOV '24-APRIL '25)

AREA FOR CONSTRUCTION TRAILERS

LIMIT OF WORK FOR EVENT CENTRE PHASE SHOULD EXTEND TO THIS AREA TO INCLUDE DRAINAGE AND GRADING WORK BY CIVIL AND LANDSCAPE WORKS TO ACCOMMODATE CITY EVENT STAGING AREAS

NCC - UTILIZE QED ACCESS

# LEGEND

-  EXTERIOR SITE WORKS
-  EVENT CENTRE & NEW NORTH STANDS

CONSTRUCTION ACCESS AND OPERATIONS  
(MARK-UP FROM MEETING 14TH JUNE 2024)

### GENERAL NOTES:

- TEMPORARY FIRE ROUTES NEED TO BE LEVEL
- 250 CARS CAN BE PARKED UNDERGROUND @ \$10 DAY/VEHICLE



**BRISBIN BROOK BEYON ARCHITECTS**  
14 DUNCAN ST 4TH FLOOR  
TORONTO, ON M5H 3G8  
(416) 591-8999

**ENTUITIVE**  
135 LAURIER AVE WEST, SUITE 413  
OTTAWA, ON K1P 5J2  
(343) 308-9274


**TMP**  
200 KING ST. WEST, SUITE 310  
TORONTO, ON M5H 3T4  
(416) 499-8000

**MULVEY & BANANI**  
90 SHEPPARD AVE EAST, SUITE 500  
TORONTO, ON M2N 3A  
(416) 751-2520

**S2O**  
530 N. WOOD STREET #C  
CHICAGO, IL 60622  
(224) 717-1999

**C.S.W.**  
319 MCRAE AVENUE, SUITE 502  
OTTAWA, ONTARIO K1Z 0B9  
(613) 729-4536

PRELIMINARY FOR DISCUSSION

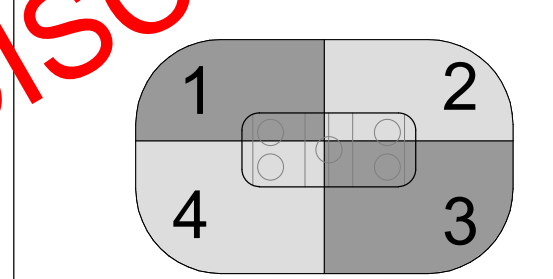

SEAL  
THIS DOCUMENT IS RELEASED FOR THE PURPOSE OF PRELIMINARY SUBMITTAL  
IT IS NOT TO BE USED FOR CONSTRUCTION PURPOSES


DRAWN JI  
DATE 01/24/24  
CHECKED SJ

## LANSDOWNE EVENT CENTRE

DWG. TITLE  
EXTENT OF EVENT CENTRE & NEW NORTH STANDS & EXTERIOR SITE WORKS

SCALE As indicated DWG. NO. A1-008f  
PROJ. NO. 2008

DATE PLOTTED: 2024-06-12 11:17:51 AM

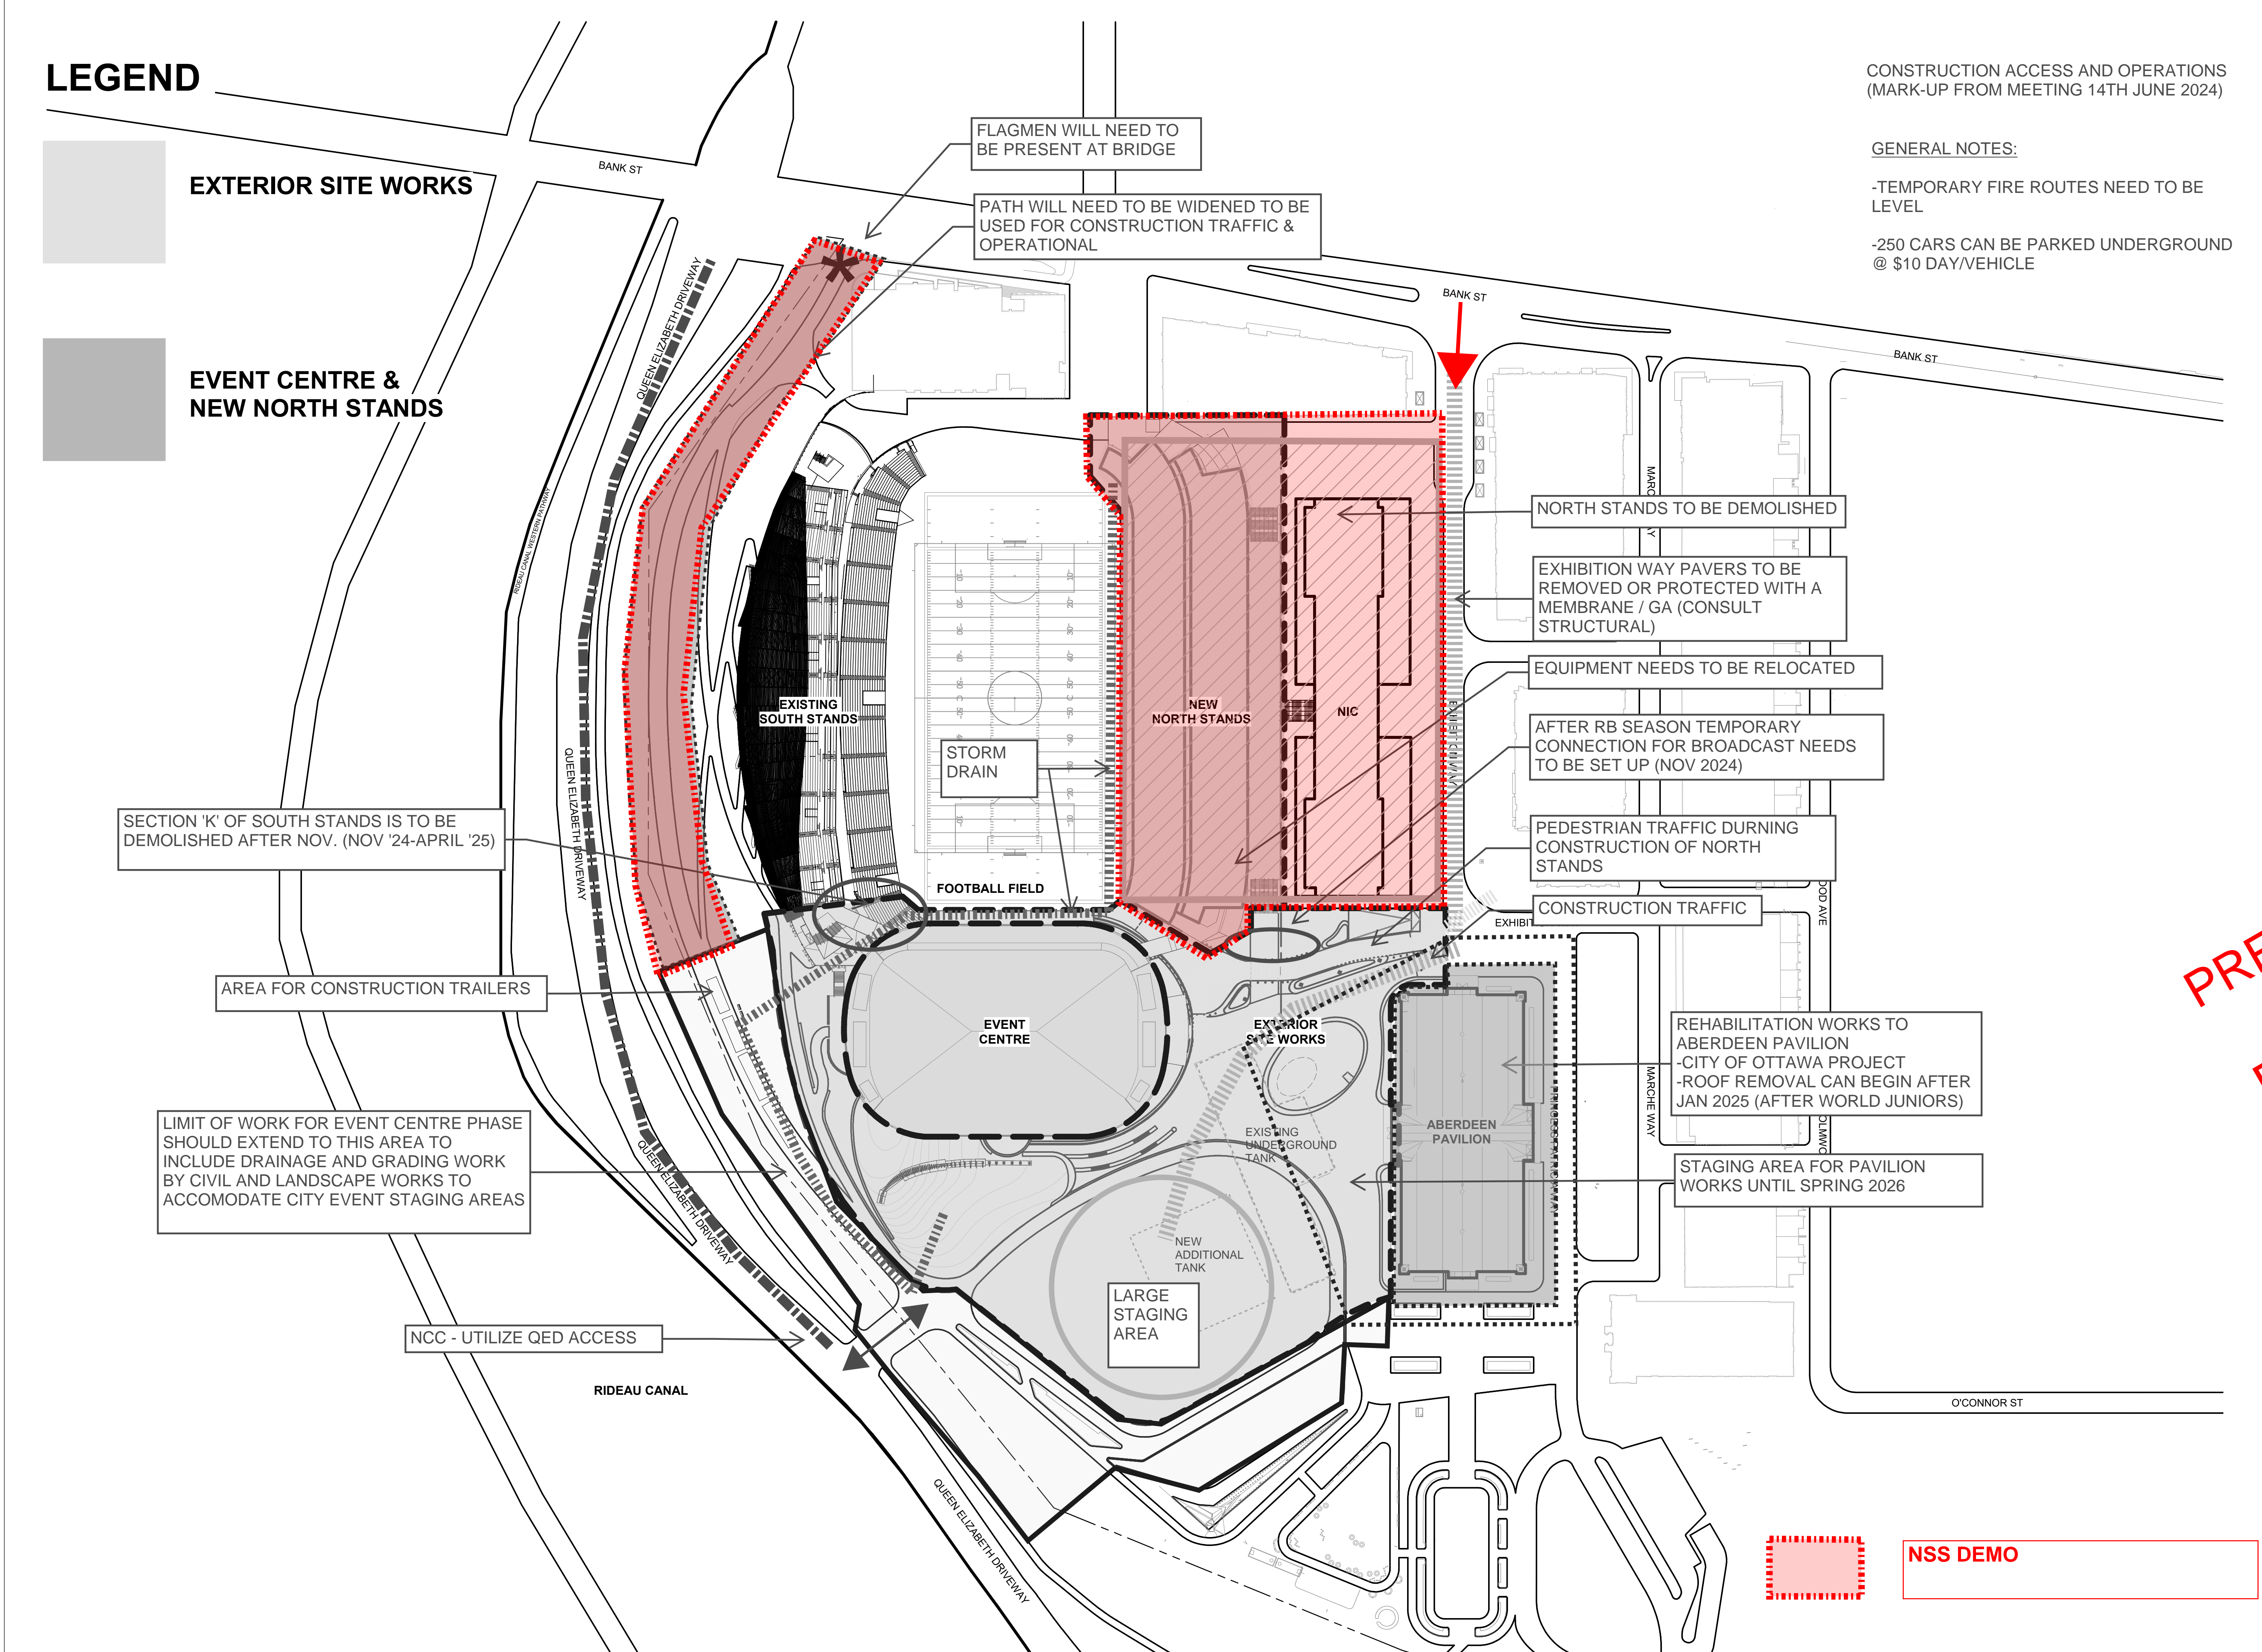

FLAGMEN WILL NEED TO BE PRESENT AT BRIDGE

PATH WILL NEED TO BE WIDENED TO BE USED FOR CONSTRUCTION TRAFFIC & OPERATIONAL

NORTH STANDS TO BE DEMOLISHED

EXHIBITION WAY PAVERS TO BE REMOVED OR PROTECTED WITH A MEMBRANE / GA (CONSULT STRUCTURAL)

EQUIPMENT NEEDS TO BE RELOCATED

AFTER RB SEASON TEMPORARY CONNECTION FOR BROADCAST NEEDS TO BE SET UP (NOV 2024)

PEDESTRIAN TRAFFIC DURING CONSTRUCTION OF NORTH STANDS

CONSTRUCTION TRAFFIC

REHABILITATION WORKS TO ABERDEEN PAVILION  
-CITY OF OTTAWA PROJECT  
-ROOF REMOVAL CAN BEGIN AFTER JAN 2025 (AFTER WORLD JUNIORS)

STAGING AREA FOR PAVILION WORKS UNTIL SPRING 2026

SECTION 'K' OF SOUTH STANDS IS TO BE DEMOLISHED AFTER NOV. (NOV '24-APRIL '25)

AREA FOR CONSTRUCTION TRAILERS

LIMIT OF WORK FOR EVENT CENTRE PHASE SHOULD EXTEND TO THIS AREA TO INCLUDE DRAINAGE AND GRADING WORK BY CIVIL AND LANDSCAPE WORKS TO ACCOMMODATE CITY EVENT STAGING AREAS

NCC - UTILIZE QED ACCESS

# LEGEND

- EXTERIOR SITE WORKS
- EVENT CENTRE & NEW NORTH STANDS

CONSTRUCTION ACCESS AND OPERATIONS (MARK-UP FROM MEETING 14TH JUNE 2024)

GENERAL NOTES:  
 -TEMPORARY FIRE ROUTES NEED TO BE LEVEL  
 -250 CARS CAN BE PARKED UNDERGROUND @ \$10 DAY/VEHICLE



BRISBIN BROOK BEYON ARCHITECTS  
 14 DUNCAN ST 4TH FLOOR  
 TORONTO, ON M5H 3G8  
 (416) 591-8999

ENTUITIVE  
 135 LAURIER AVE WEST, SUITE 413  
 OTTAWA, ON K1P 5J2  
 (343) 308-9274

TMP  
 200 KING ST. WEST, SUITE 310  
 TORONTO, ON M5H 3T4  
 (416) 499-8000


MULVEY & BANANI  
 90 SHEPPARD AVE EAST, SUITE 500  
 TORONTO, ON M2N 3A  
 (416) 751-2520

S2O  
 530 N. WOOD STREET #C  
 CHICAGO, IL 60622  
 (224) 717-1999

C.S.W.  
 319 MCRAE AVENUE, SUITE 502  
 OTTAWA, ON K1Z 0B9  
 (613) 226-6633

**PRELIMINARY FOR DISCUSSION**

REVISIONS/ ISSUES  
 CONTRACTOR SHALL CHECK AND VERIFY ALL DIMENSIONS AND REPORT ANY OMISSIONS OR DISCREPANCIES TO THE ARCHITECT BEFORE PROCEEDING WITH THE WORK. DO NOT SCALE THE DRAWINGS

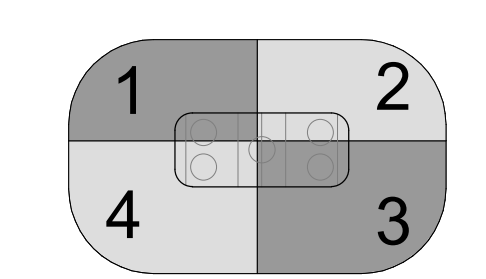

SEAL  
 THIS DOCUMENT IS RELEASED FOR THE PURPOSE OF PRELIMINARY SUBMITTAL  
 IT IS NOT TO BE USED FOR CONSTRUCTION PURPOSES

DRAWN: JI  
 DATE: 01/24/24  
 CHECKED: SJ


## LANSDOWNE EVENT CENTRE

DWG. TITLE  
 EXTENT OF EVENT CENTRE & NEW NORTH STANDS & EXTERIOR SITE WORKS

SCALE: As indicated  
 PROJ. NO.: 2008  
 DWG. NO.: A1-008f

DATE PLOTTED: 2024-06-12 11:17:51 AM

EXTENT OF EVENT CENTRE & NEW NORTH STANDS & EXTERIOR SITE WORKS  
 1:1000

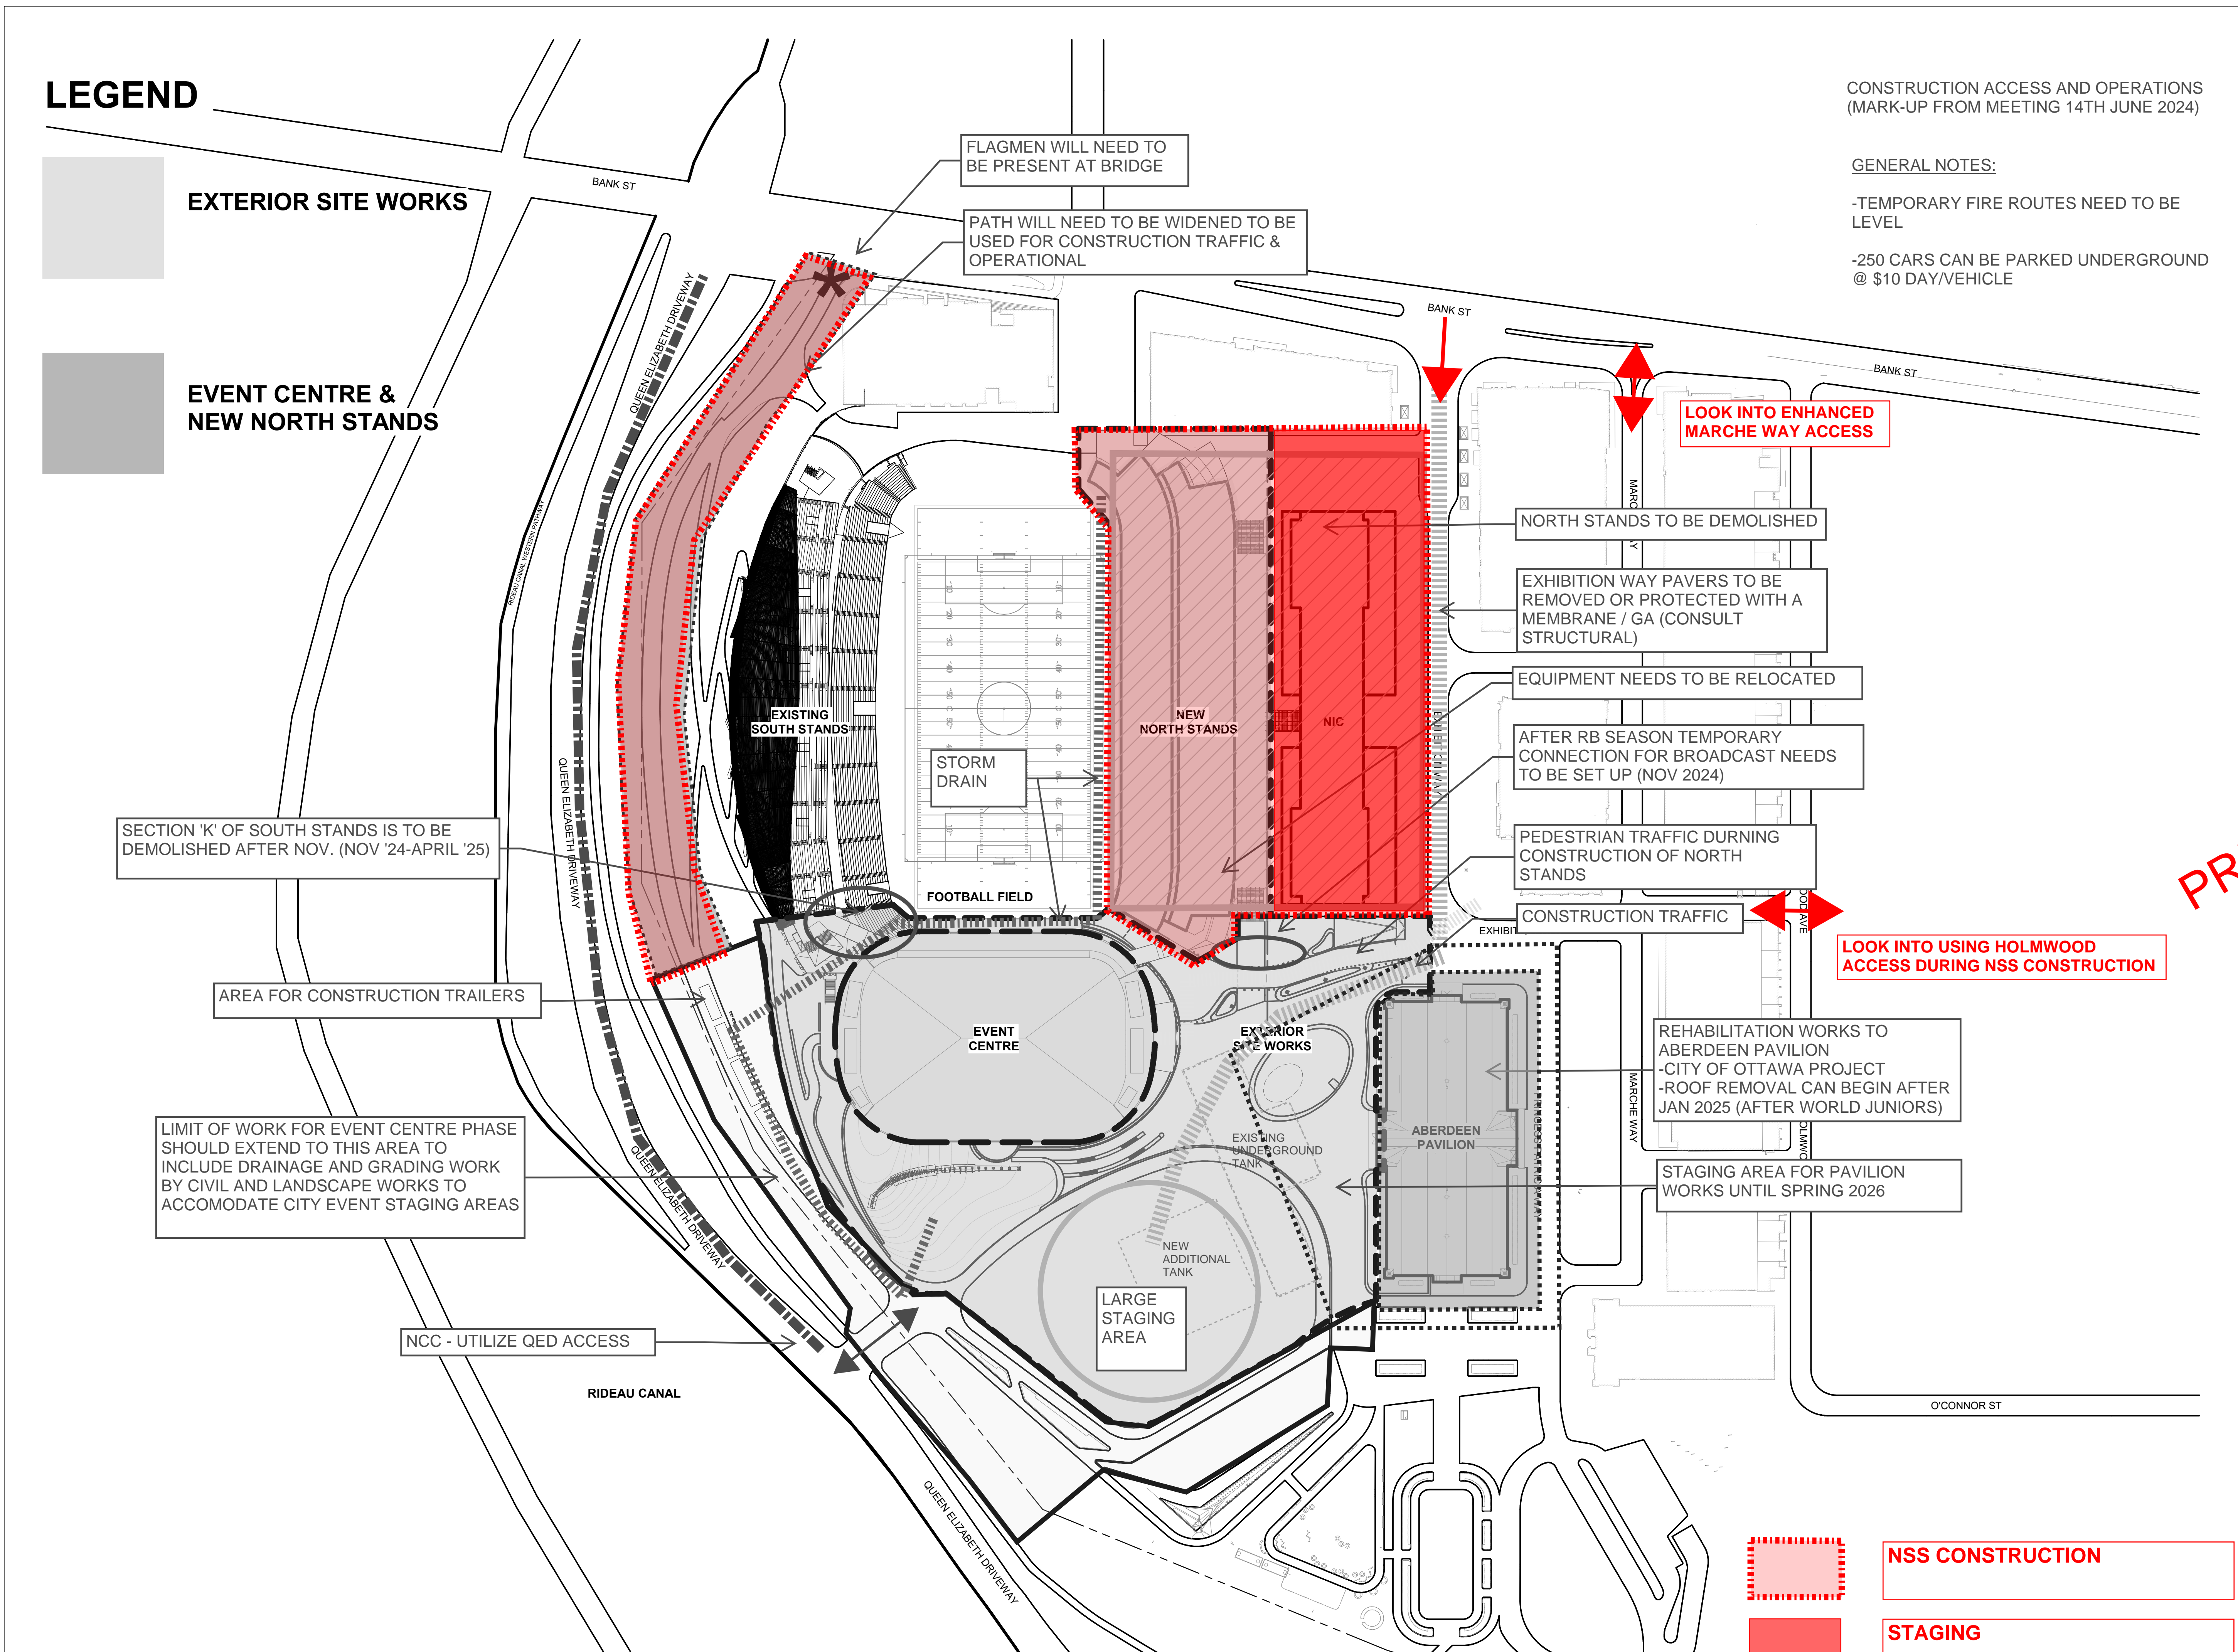

- NSS CONSTRUCTION
- STAGING