
SITE PLAN

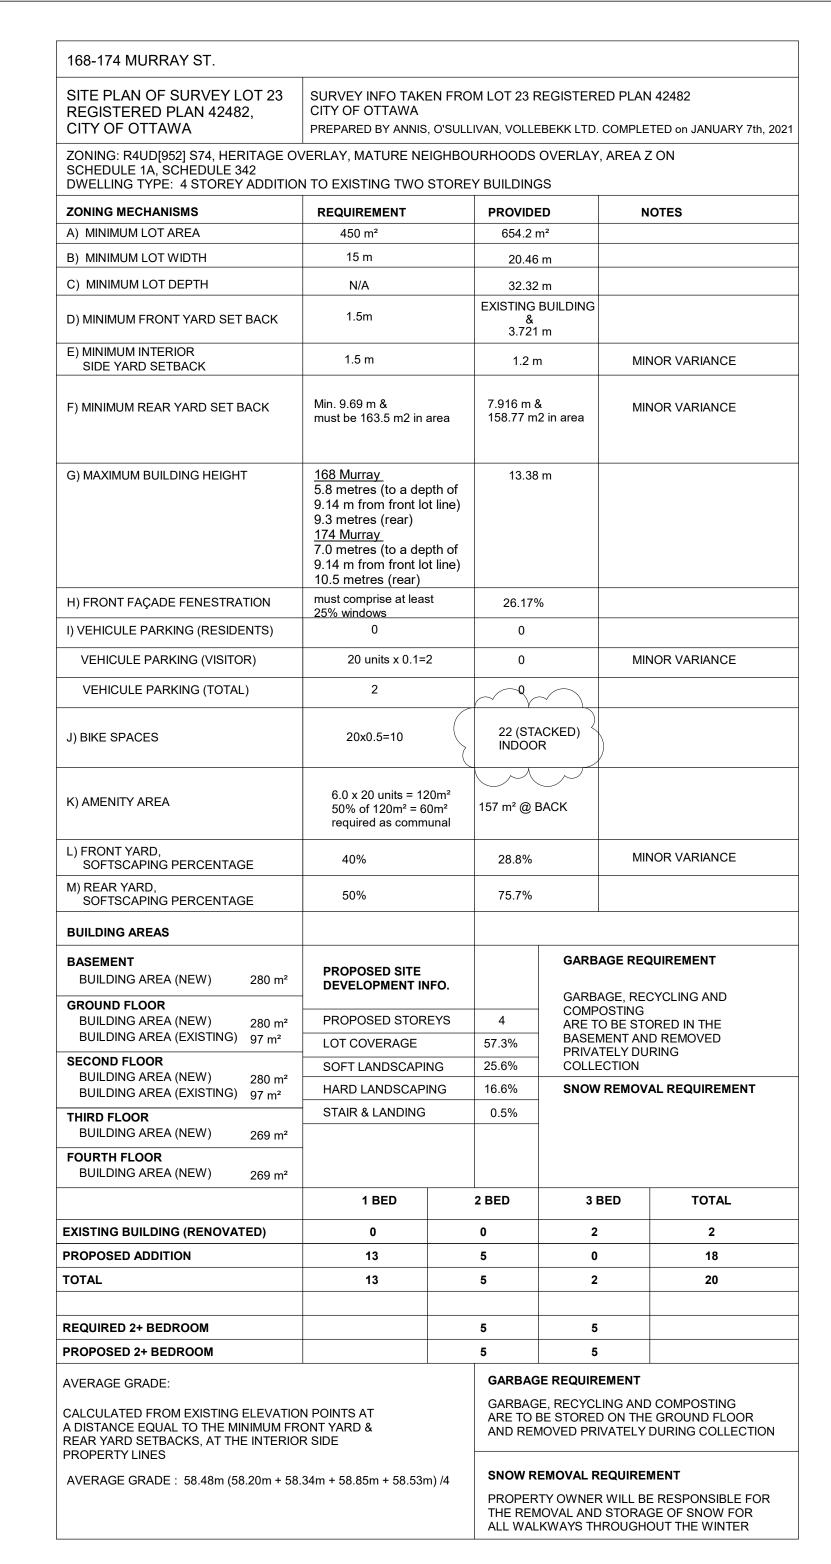

LOT LOCATION

<u>LEGEND</u>

NEW TREE

EX. TREE TO BE REMOVED

EXISTING BUILDING TO REMAIN

DENOTES HARD LANDSCAPING

DENOTES SOFT LANDSCAPING

PROPOSED / EXISTING ENTRY / EXIT

PROPOSED BUILDING

PROPERTY LINE

689

ACCORDANCE WITH ALL LAWS, REGULATIONS AND BYLAWS HAVING JURISDICTION CONTRACTOR TO CHECK AND VERIFY ALL DIMENSIONS ON SITE AND REPORT ALL ERRORS AND OMISSIONS TO THE ARCHITECT/DESIGNER GENERAL NOTES: O ARCHITECTS LEVENT TATAR

RESPONSIBILITIES: DO NOT SCALE DRAWINGS ALL DESIGN AND CONSTRUCTION TO BE IN ACCORDANCE WITH THE ONTARIO BUILDING CODE 2012 CONSTRUCTION UNTIL SIGNED BY THE ARCHITECT COPYRIGHT RESERVED

RA REDLINE ARCHITECTURE

REDLINE ARCHITECTURE INC.

Tel: 613-612-2232

www.redlinearchitecture.ca

LICENCE 9542

CONSULTANTS STRUCTURAL MECHANICAL -ELECTRICAL -REVISION/ISSUE 168-174 MURRAY ST. 4 STOREY ADDITION TO EXISTING TWO STOREY BUILDINGS 168-174 MURRAY ST. OTTAWA, ON K1N 5M8

SITE PLAN

DATE:.MAY 11, 2021 SCALE: AS NOTED



74 MURRAY ST.

7 ADDITION TO EXISTING STOREY BUILDINGS

RA REDLINE ARCHITECTURE

REDLINE ARCHITECTURE INC. Tel: 613-612-2232 info@redlinearchitecture.ca www.redlinearchitecture.ca

RESPONSIBILITIES: DO NOT SCALE DRAWINGS

ALL DESIGN AND CONSTRUCTION TO BE IN ACCORDANCE WITH THE ONTARIO BUILDING CODE 2012

ALL CONTRACTORS MUST WORK IN ACCORDANCE WITH ALL LAWS, REGULATIONS AND BYLAWS HAVING JURISDICTION

IT IS THE RESPONSIBILITY OF THE APPROPRIATE CONTRACTOR TO CHECK AND VERIFY ALL DIMENSIONS ON SITE AND REPORT ALL ERRORS AND OMISSIONS TO THE ARCHITECT/DESIGNER

RIO ASSOC

LEVENT TATAR
LICENCE
9542

O ARCHITECTS

THIS DRAWING MAY NOT BE USED FOR CONSTRUCTION UNTIL SIGNED BY THE ARCHITECT

COPYRIGHT RESERVED


GENERAL NOTES:

168

CONSULTANTS : STRUCTURAL -MECHANICAL -ELECTRICAL -REVISION/ISSUE 168-174 MURRAY ST. 4 STOREY ADDITION TO EXISTING TWO STOREY BUILDINGS 168-174 MURRAY ST. OTTAWA, ON K1N 5M8

FLOOR PLANS


DATE:.MAY 11, 2021 SCALE: AS NOTED

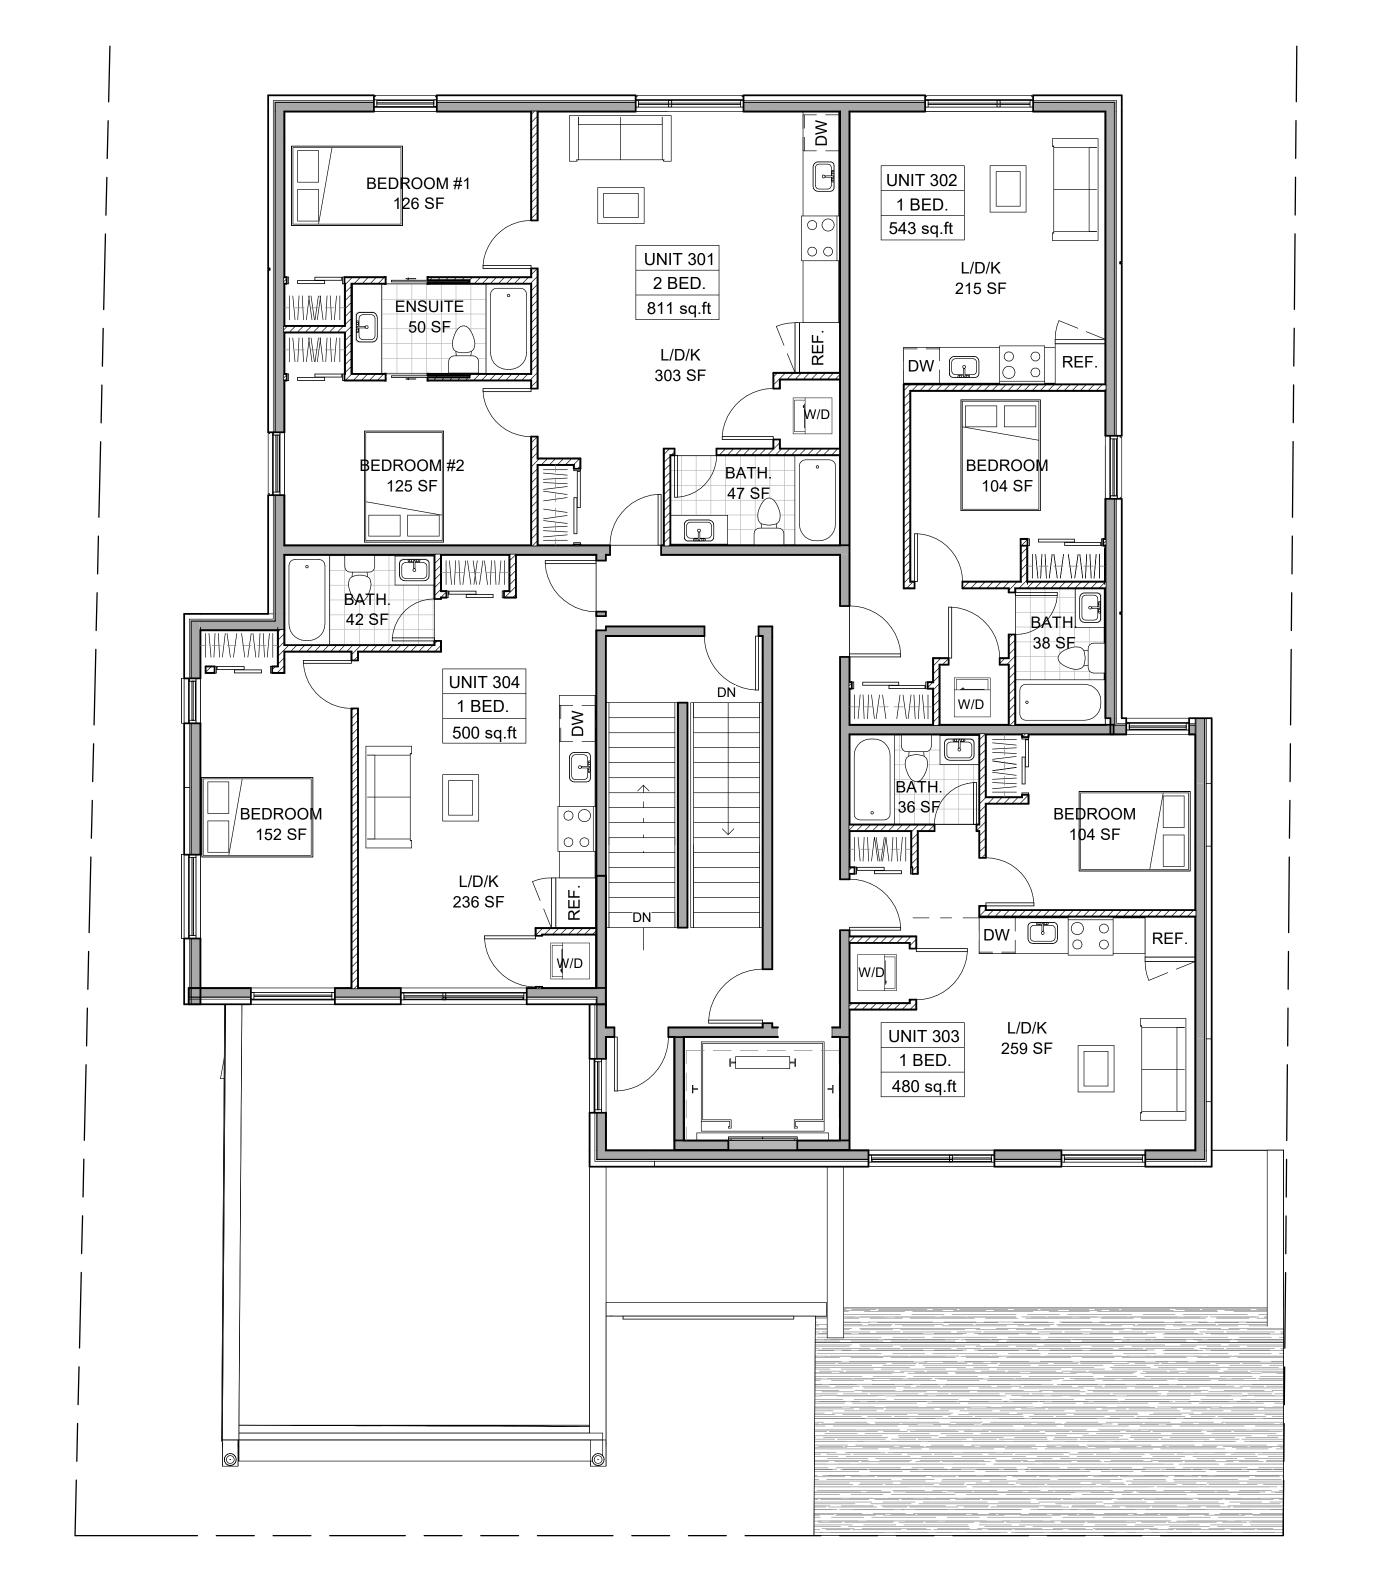

EXISTING BUILDING TO REMAIN

THIRD & FOURTH FLOORS

3/16" = 1'-0"

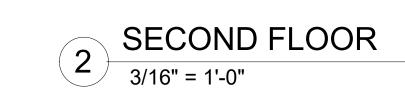



CONSULTANTS : STRUCTURAL -MECHANICAL -ELECTRICAL -

REVISION/ISSUE

168-174 MURRAY ST.

4 STOREY ADDITION TO EXISTING TWO STOREY BUILDINGS 168-174 MURRAY ST. OTTAWA, ON K1N 5M8

FLOOR PLANS

DATE: MAY 11, 2021

SCALE: AS NOTED

RA REDLINE ARCHITECTURE

REDLINE ARCHITECTURE INC.

Tel: 613-612-2232 info@redlinearchitecture.ca www.redlinearchitecture.ca

RESPONSIBILITIES: DO NOT SCALE DRAWINGS

ALL DESIGN AND CONSTRUCTION TO BE IN ACCORDANCE WITH THE ONTARIO BUILDING CODE 2012

ALL CONTRACTORS MUST WORK IN ACCORDANCE WITH ALL LAWS, REGULATIONS AND BYLAWS HAVING JURISDICTION

IT IS THE RESPONSIBILITY OF THE APPROPRIATE CONTRACTOR TO CHECK AND VERIFY ALL DIMENSIONS ON SITE AND REPORT ALL ERRORS AND OMISSIONS TO THE ARCHITECT/DESIGNER

THIS DRAWING MAY NOT BE USED FOR CONSTRUCTION UNTIL SIGNED BY THE ARCHITECT


ASSOCK

O ARCHITECTS Z

LEVENT TATAR
LICENCE
9542

COPYRIGHT RESERVED

GENERAL NOTES:

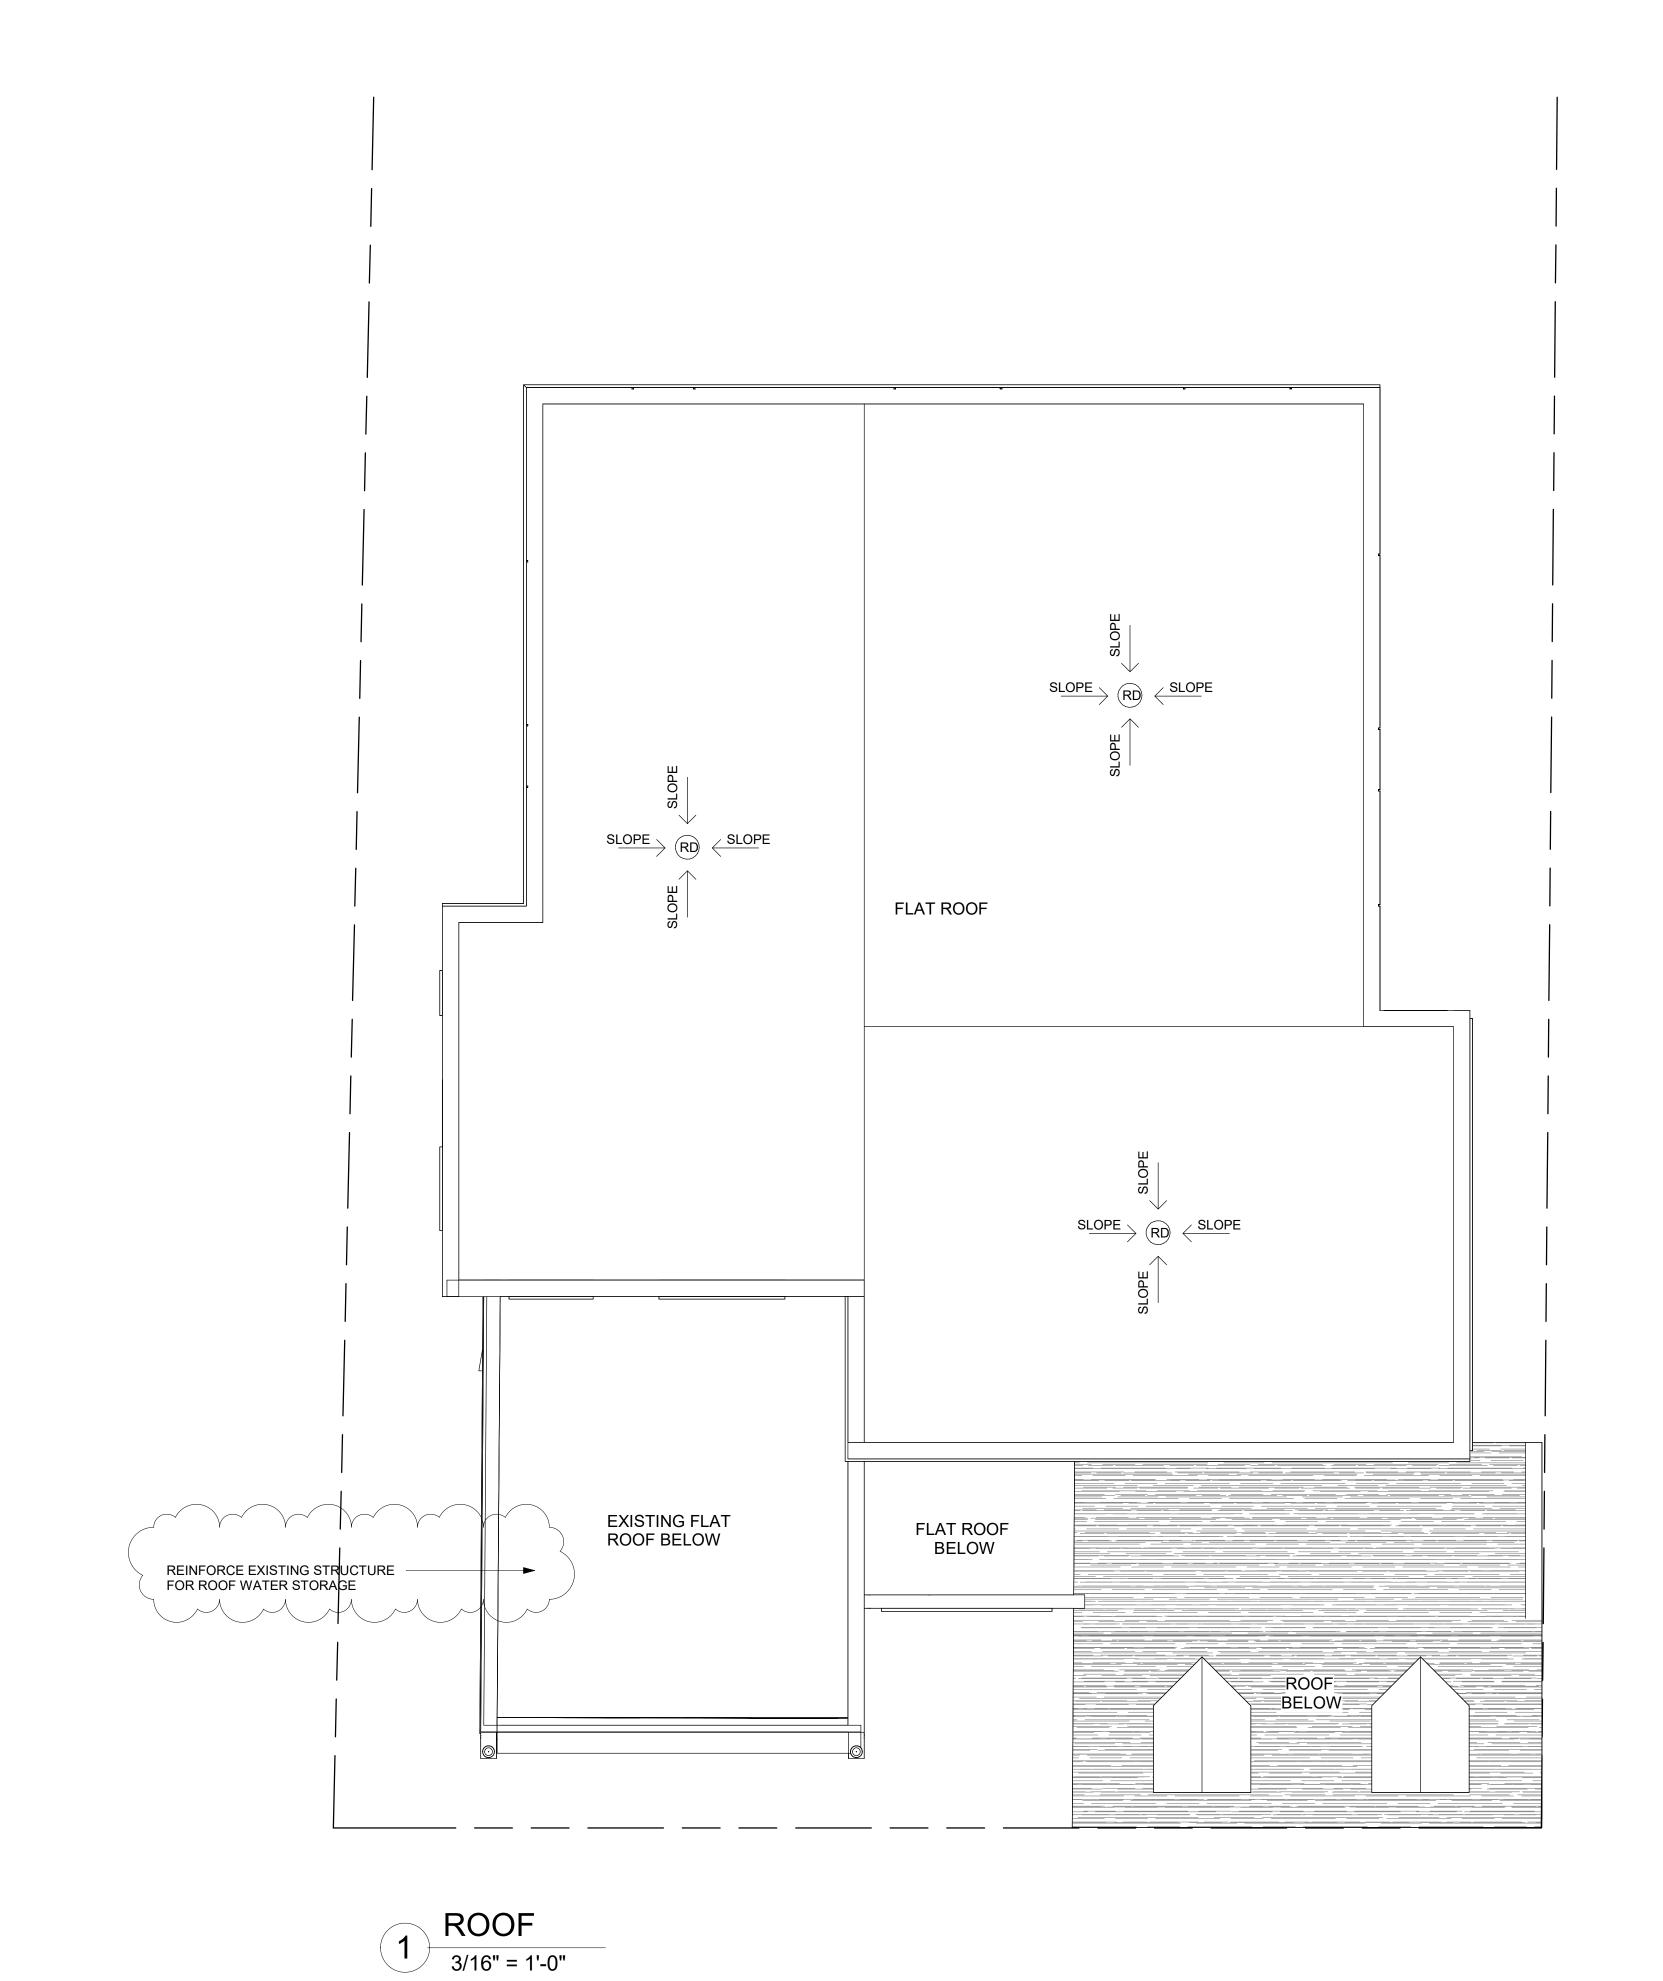

THIS DRAWING MAY NOT BE USED FOR CONSTRUCTION UNTIL SIGNED BY THE ARCHITECT

COPYRIGHT RESERVED

GENERAL NOTES:

RESPONSIBILITIES:

DO NOT SCALE DRAWINGS

ALL DESIGN AND CONSTRUCTION TO BE IN ACCORDANCE WITH THE ONTARIO BUILDING CODE 2012

ALL CONTRACTORS MUST WORK IN ACCORDANCE WITH ALL LAWS, REGULATIONS AND BYLAWS HAVING JURISDICTION

IT IS THE RESPONSIBILITY OF THE APPROPRIATE CONTRACTOR TO CHECK AND VERIFY ALL DIMENSIONS ON SITE AND REPORT ALL ERRORS AND OMISSIONS TO THE ARCHITECT/DESIGNER

RA REDLINE ARCHITECTURE

REDLINE ARCHITECTURE INC.

Tel: 613-612-2232 info@redlinearchitecture.ca www.redlinearchitecture.ca

NO. REVISION/ISSUE DATE
PROJECT:
168-174 MURRAY ST.
4 STOREY ADDITION TO EXISTING
TWO STOREY BUILDINGS
168-174 MURRAY ST.
OTTAWA, ON K1N 5M8

FLOOR PLANS

CONSULTANTS

: STRUCTURAL -MECHANICAL -ELECTRICAL -

DRAWN BY:

DATE: MAY 11, 2021

SCALE: AS NOTED



ALL DESIGN AND CONSTRUCTION TO BE IN ACCORDANCE WITH THE ONTARIO BUILDING CODE 2012 IT IS THE RESPONSIBILITY OF THE APPROPRIATE CONTRACTOR TO CHECK AND VERIFY ALL DIMENSIONS ON SITE AND REPORT ALL ERRORS AND OMISSIONS TO THE ARCHITECT/DESIGNER