


"FUTURE RESIDENTIAL"
LANDS OWNED BY OTHERS



LOT 4, CONCESSION 3 (OTTAWA FRONT)

"EXISTING INDUSTRIAL"
LANDS OWNED BY OTHERS

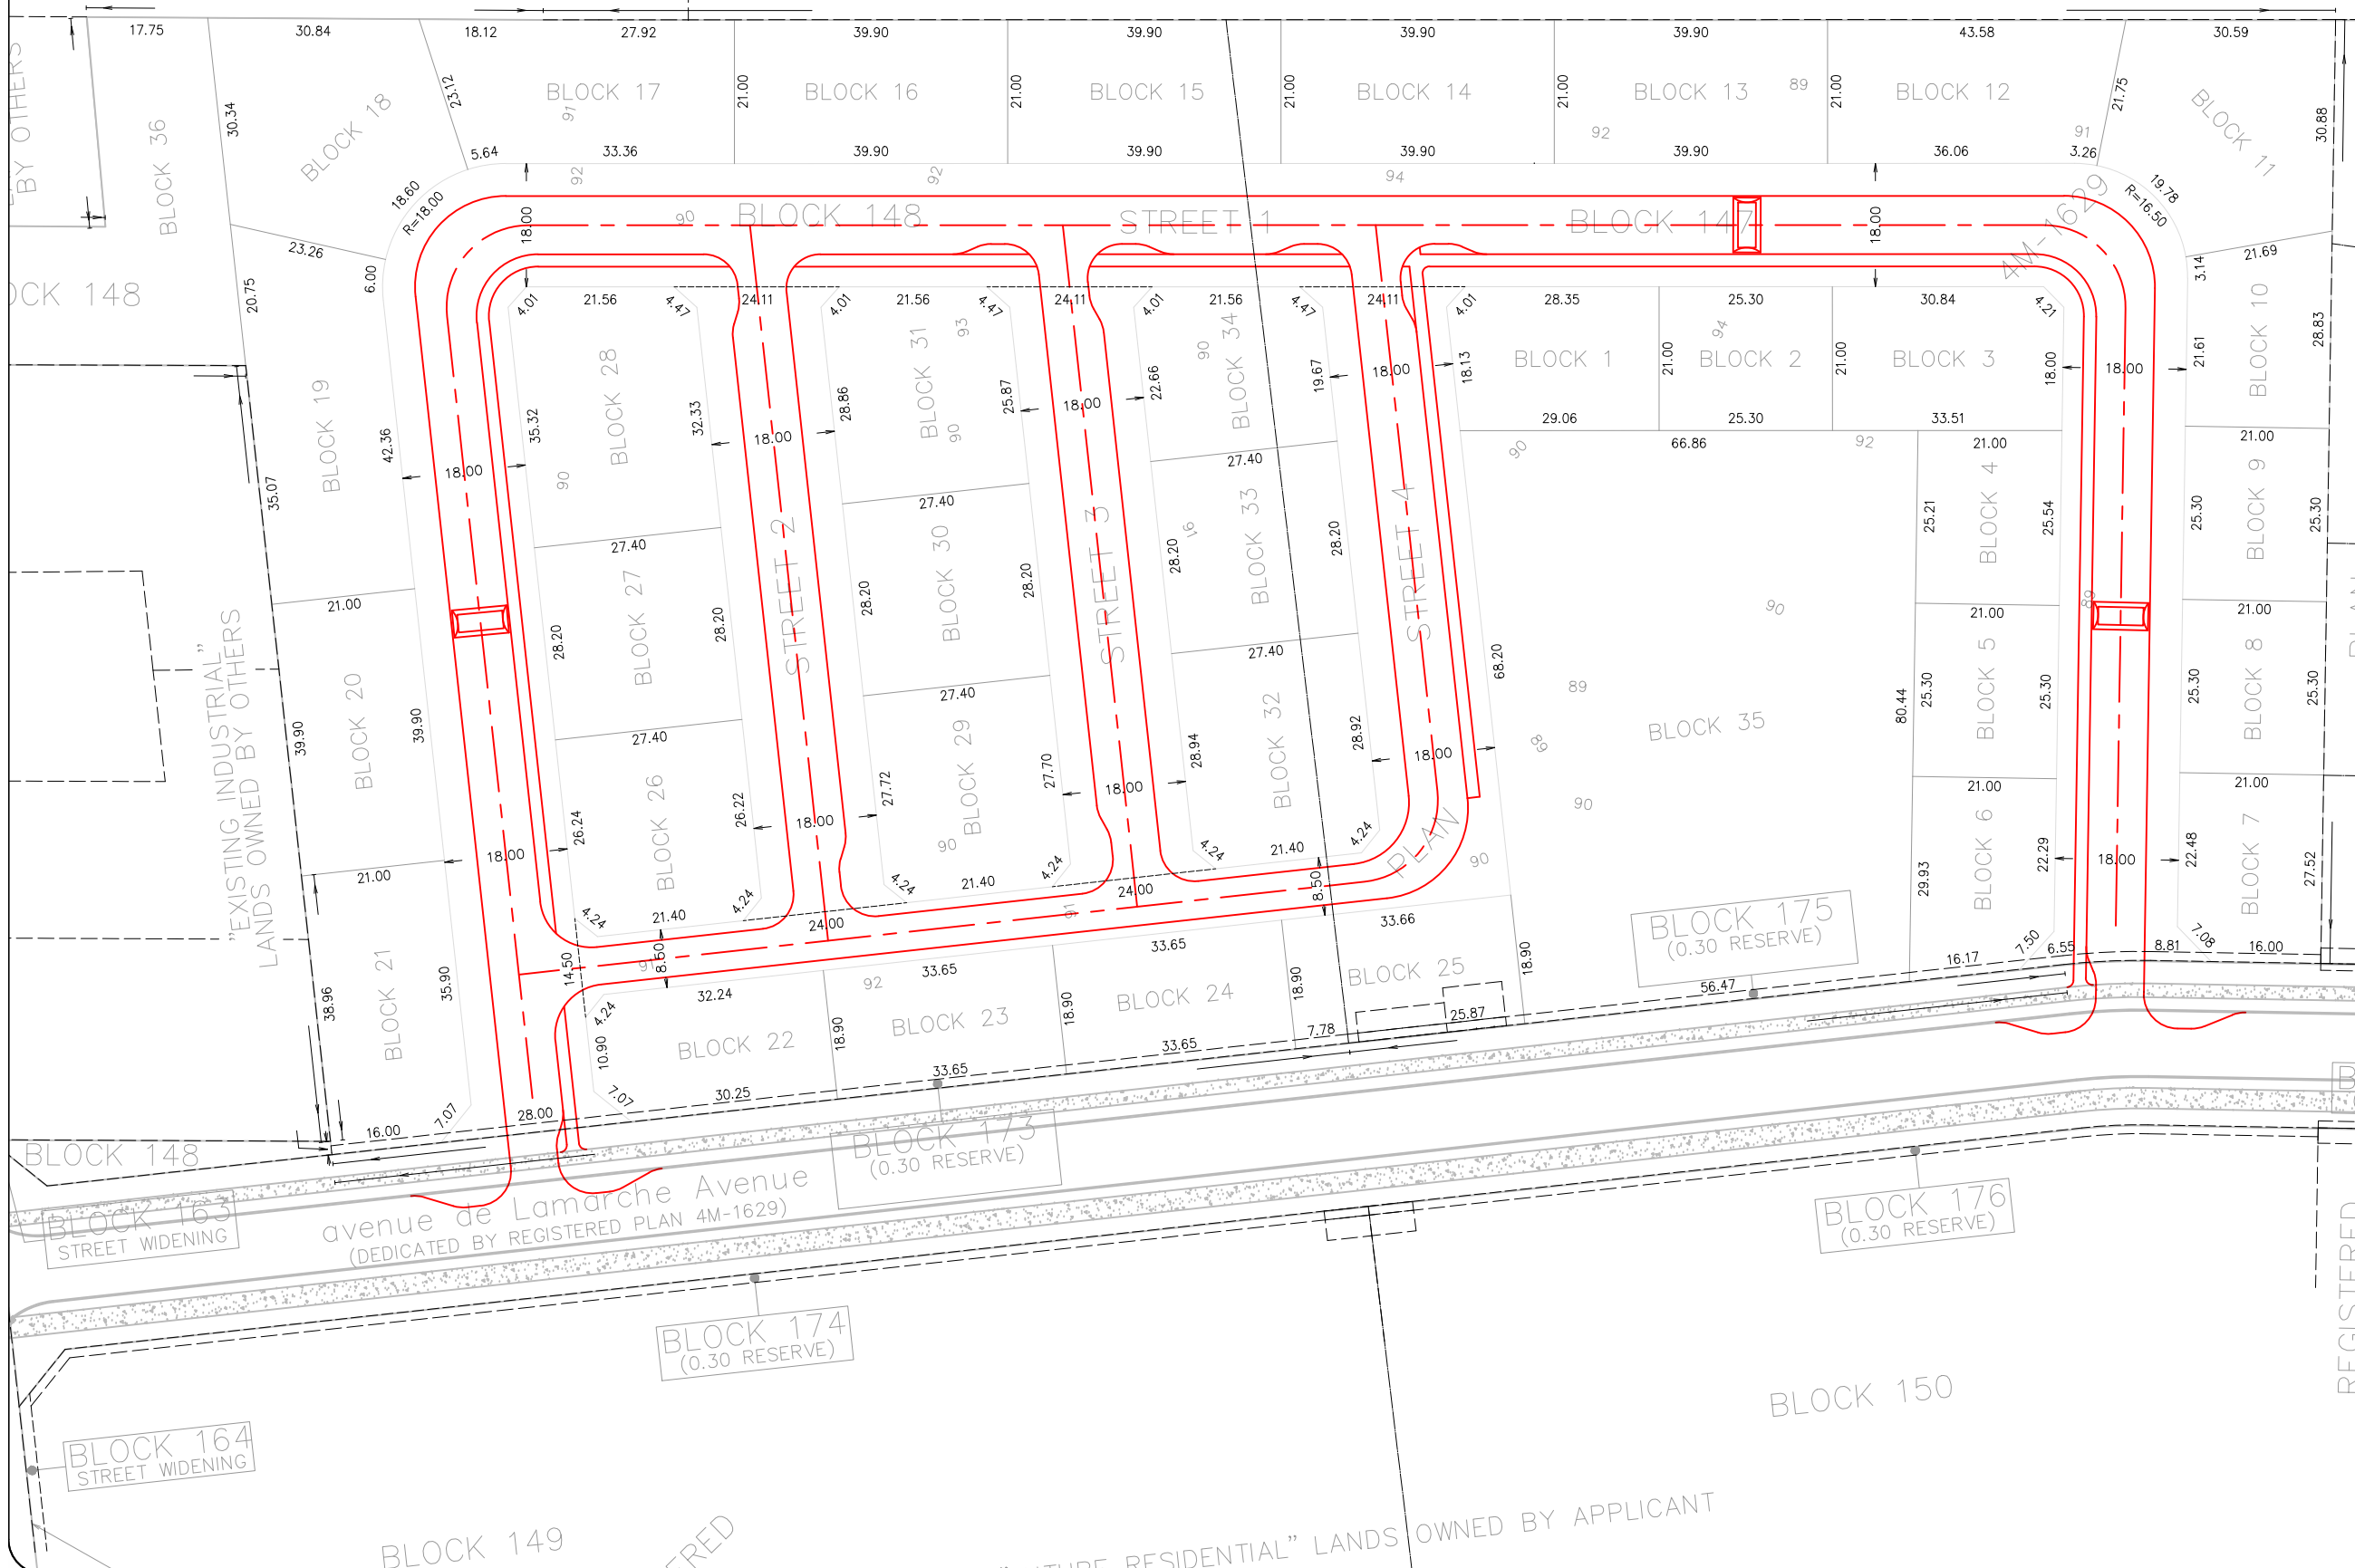

Notes:

01	Issued for Review	By	2022-04-12
REV:	DESCRIPTION:	BY:	DATE:
STATUS:			

CGH Transportation
 6 Plaza Court
 Ottawa, ON
 K2H 7W1
 (343) 999-9117

CLIENT: Caivan (Orleans Village 2) Ltd
 2934 Baseline Road, Suite 302h
 Ottawa, ON
 K2H 1B2

ARCHITECT:

SITE: 245-275 Lamarche Ave			
TITLE: Geometric Road Design Redline			
SCALE AT A3: NTS	DATE: 2022-04-12	DRAWN: BB	CHECKED: AL
PROJECT NO: 2022-023	DRAWING NO: 001	REVISION: 01	

BLOCK 164
STREET WIDENING

BLOCK 163
STREET WIDENING

BLOCK 174
(0.30 RESERVE)

BLOCK 173
(0.30 RESERVE)

BLOCK 176
(0.30 RESERVE)

BLOCK 149

BLOCK 150

"FUTURE RESIDENTIAL" LANDS OWNED BY APPLICANT

REGISTERED