


Notes:

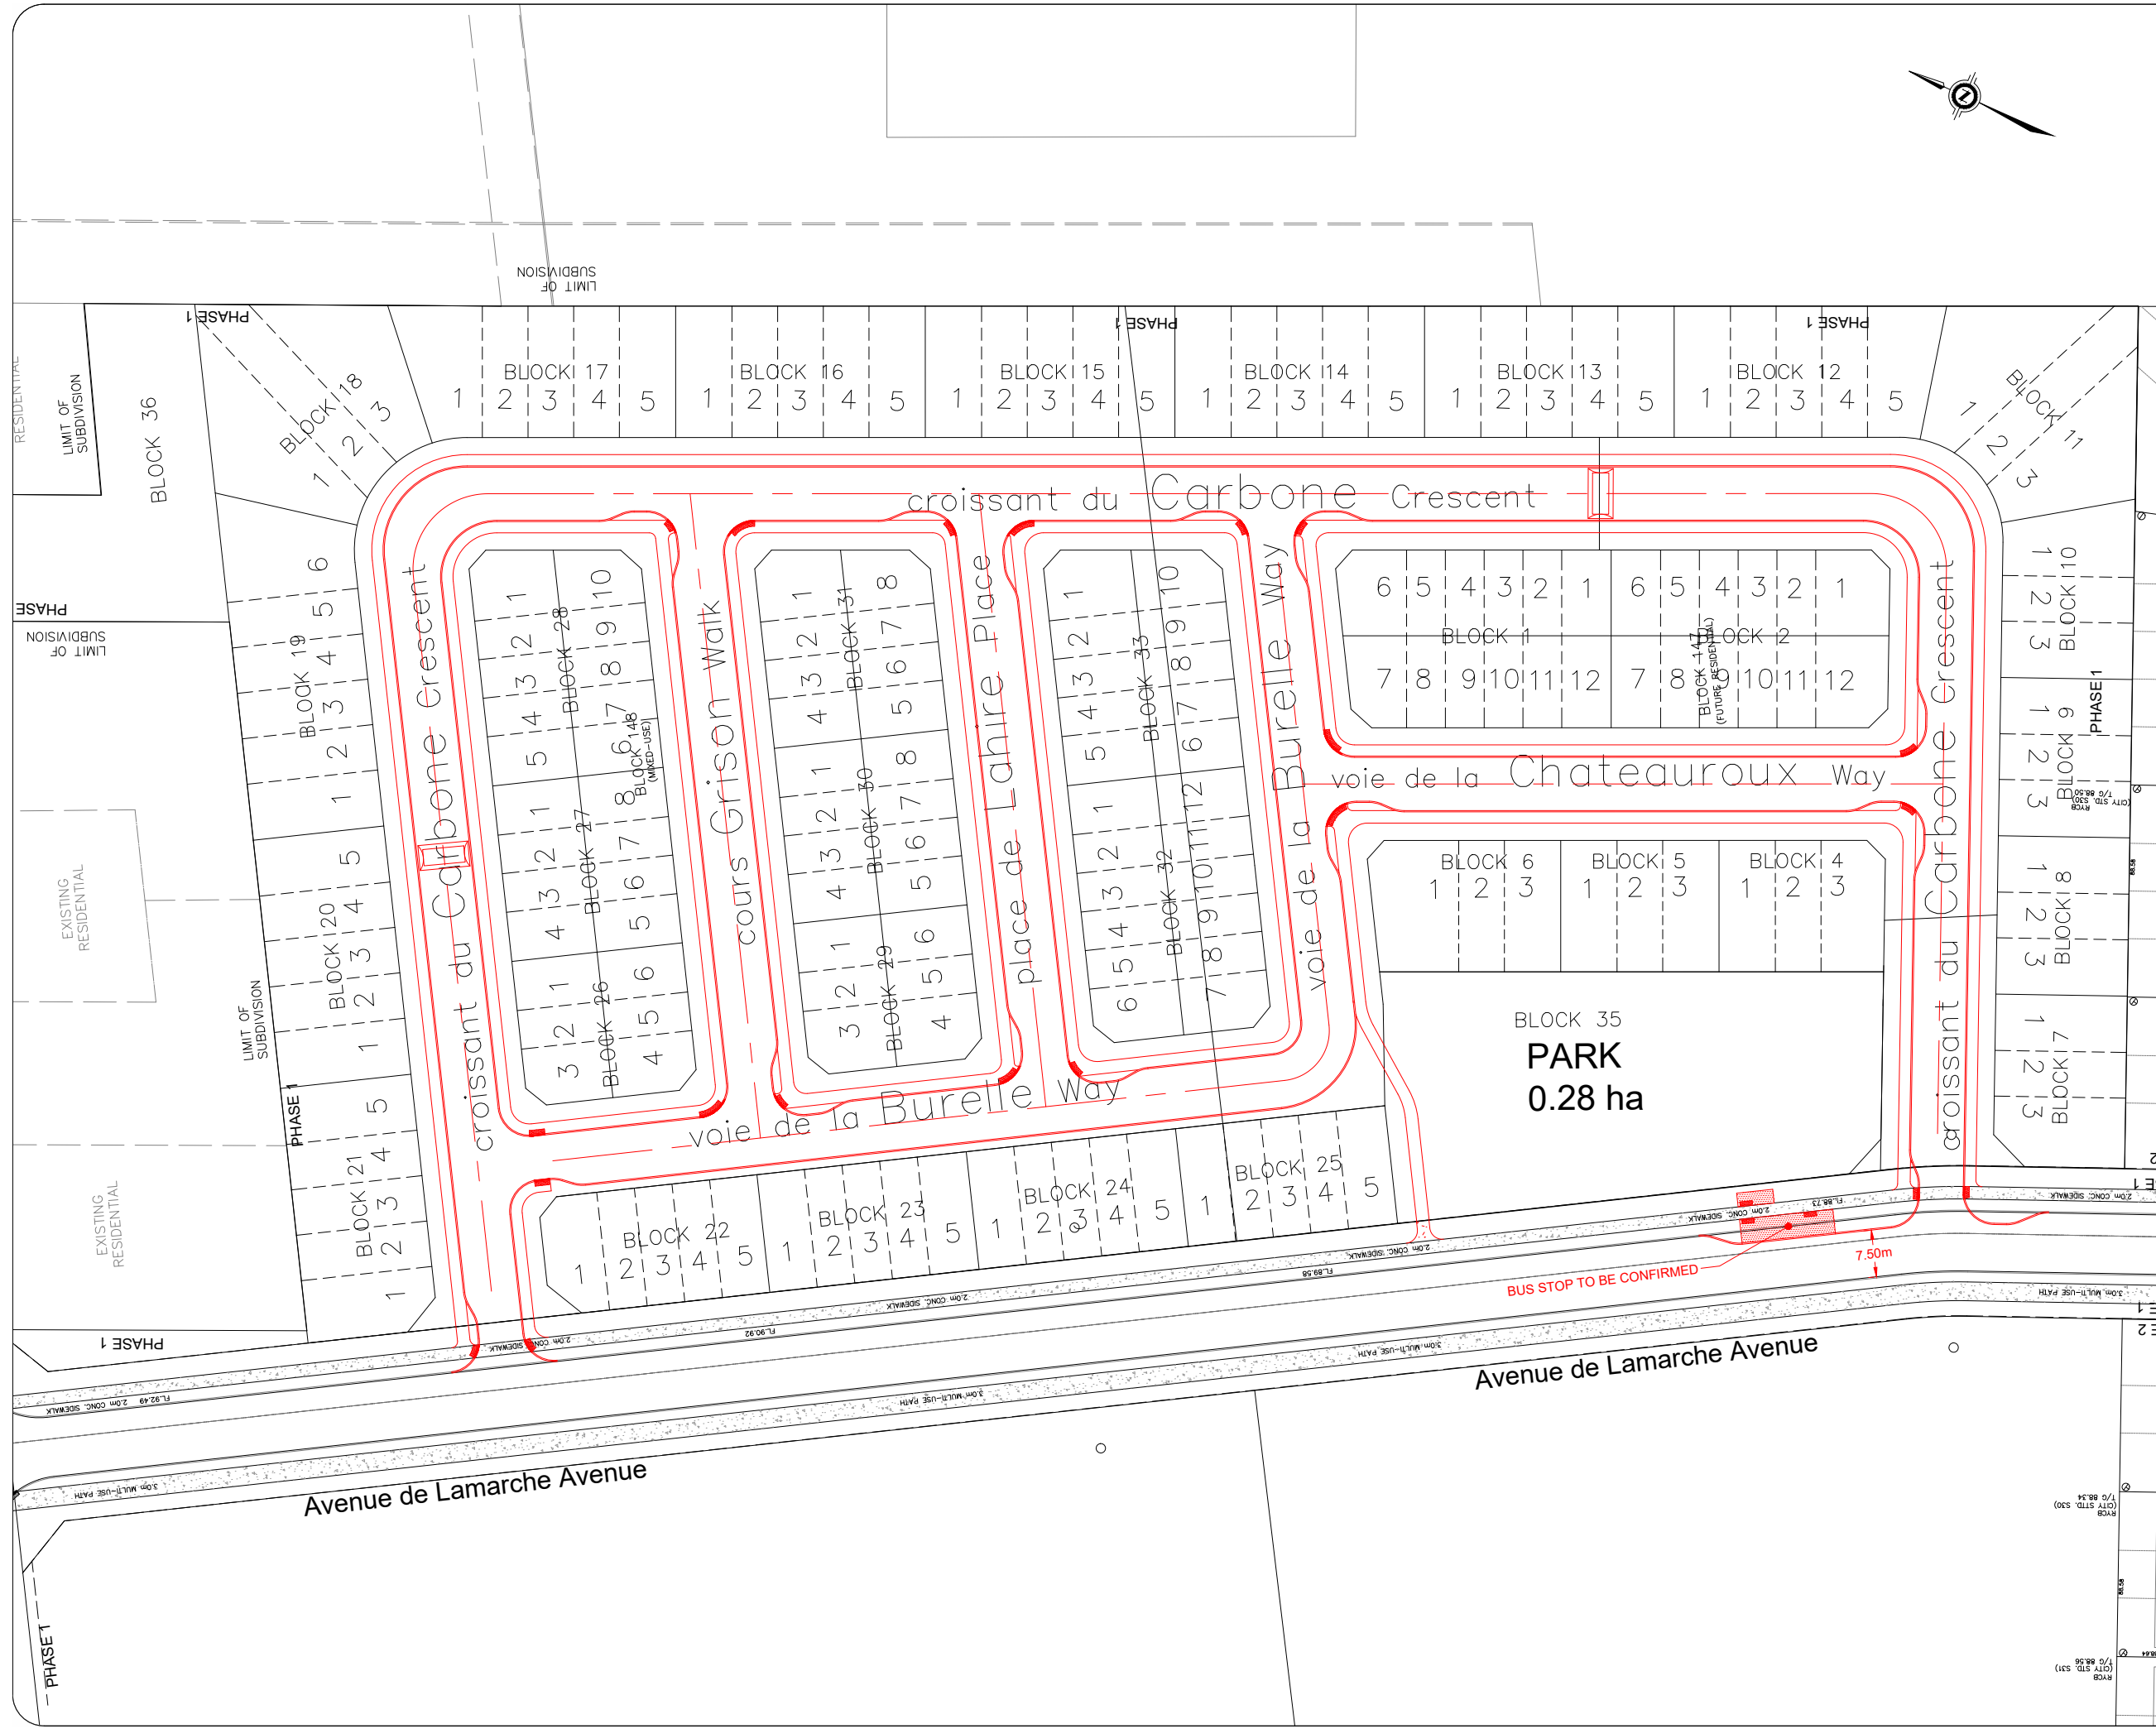

REV:	DESCRIPTION:	BY:	DATE:
04	Updated Site Plan	BB	2022-12-09
03	Updated Site Plan	BB	2022-07-27
02	Updated Site Plan	BB	2022-07-19
01	Issued for Review	BB	2022-04-12

STATUS:



CGH Transportation
6 Plaza Court
Ottawa, ON
K2H 7W1
(343) 999-9117

CLIENT: Caivan (Orleans Village 2) Ltd
2934 Baseline Road, Suite 302h
Ottawa, ON
K2H 1B2

ARCHITECT:

SITE: 245-275 Lamarche Ave

TITLE: Geometric Road Design Redline

SCALE AT A3: NTS	DATE: 2022-12-09	DRAWN: BB	CHECKED: AL
PROJECT NO: 2022-023	DRAWING NO: 001	REVISION: 04	

Avenue de Lamarche Avenue

Avenue de Lamarche Avenue

BUS STOP TO BE CONFIRMED

7.50m

BLOCK 35
PARK
0.28 ha

croissant du Carbone Crescent

voie de la Chateauroux Way

voie de la Burelle Way

croissant du Carbone Crescent

cours Grison Walk

place de Lahire Place

voie de la Burelle Way

croissant du Carbone Crescent

