


Notes:

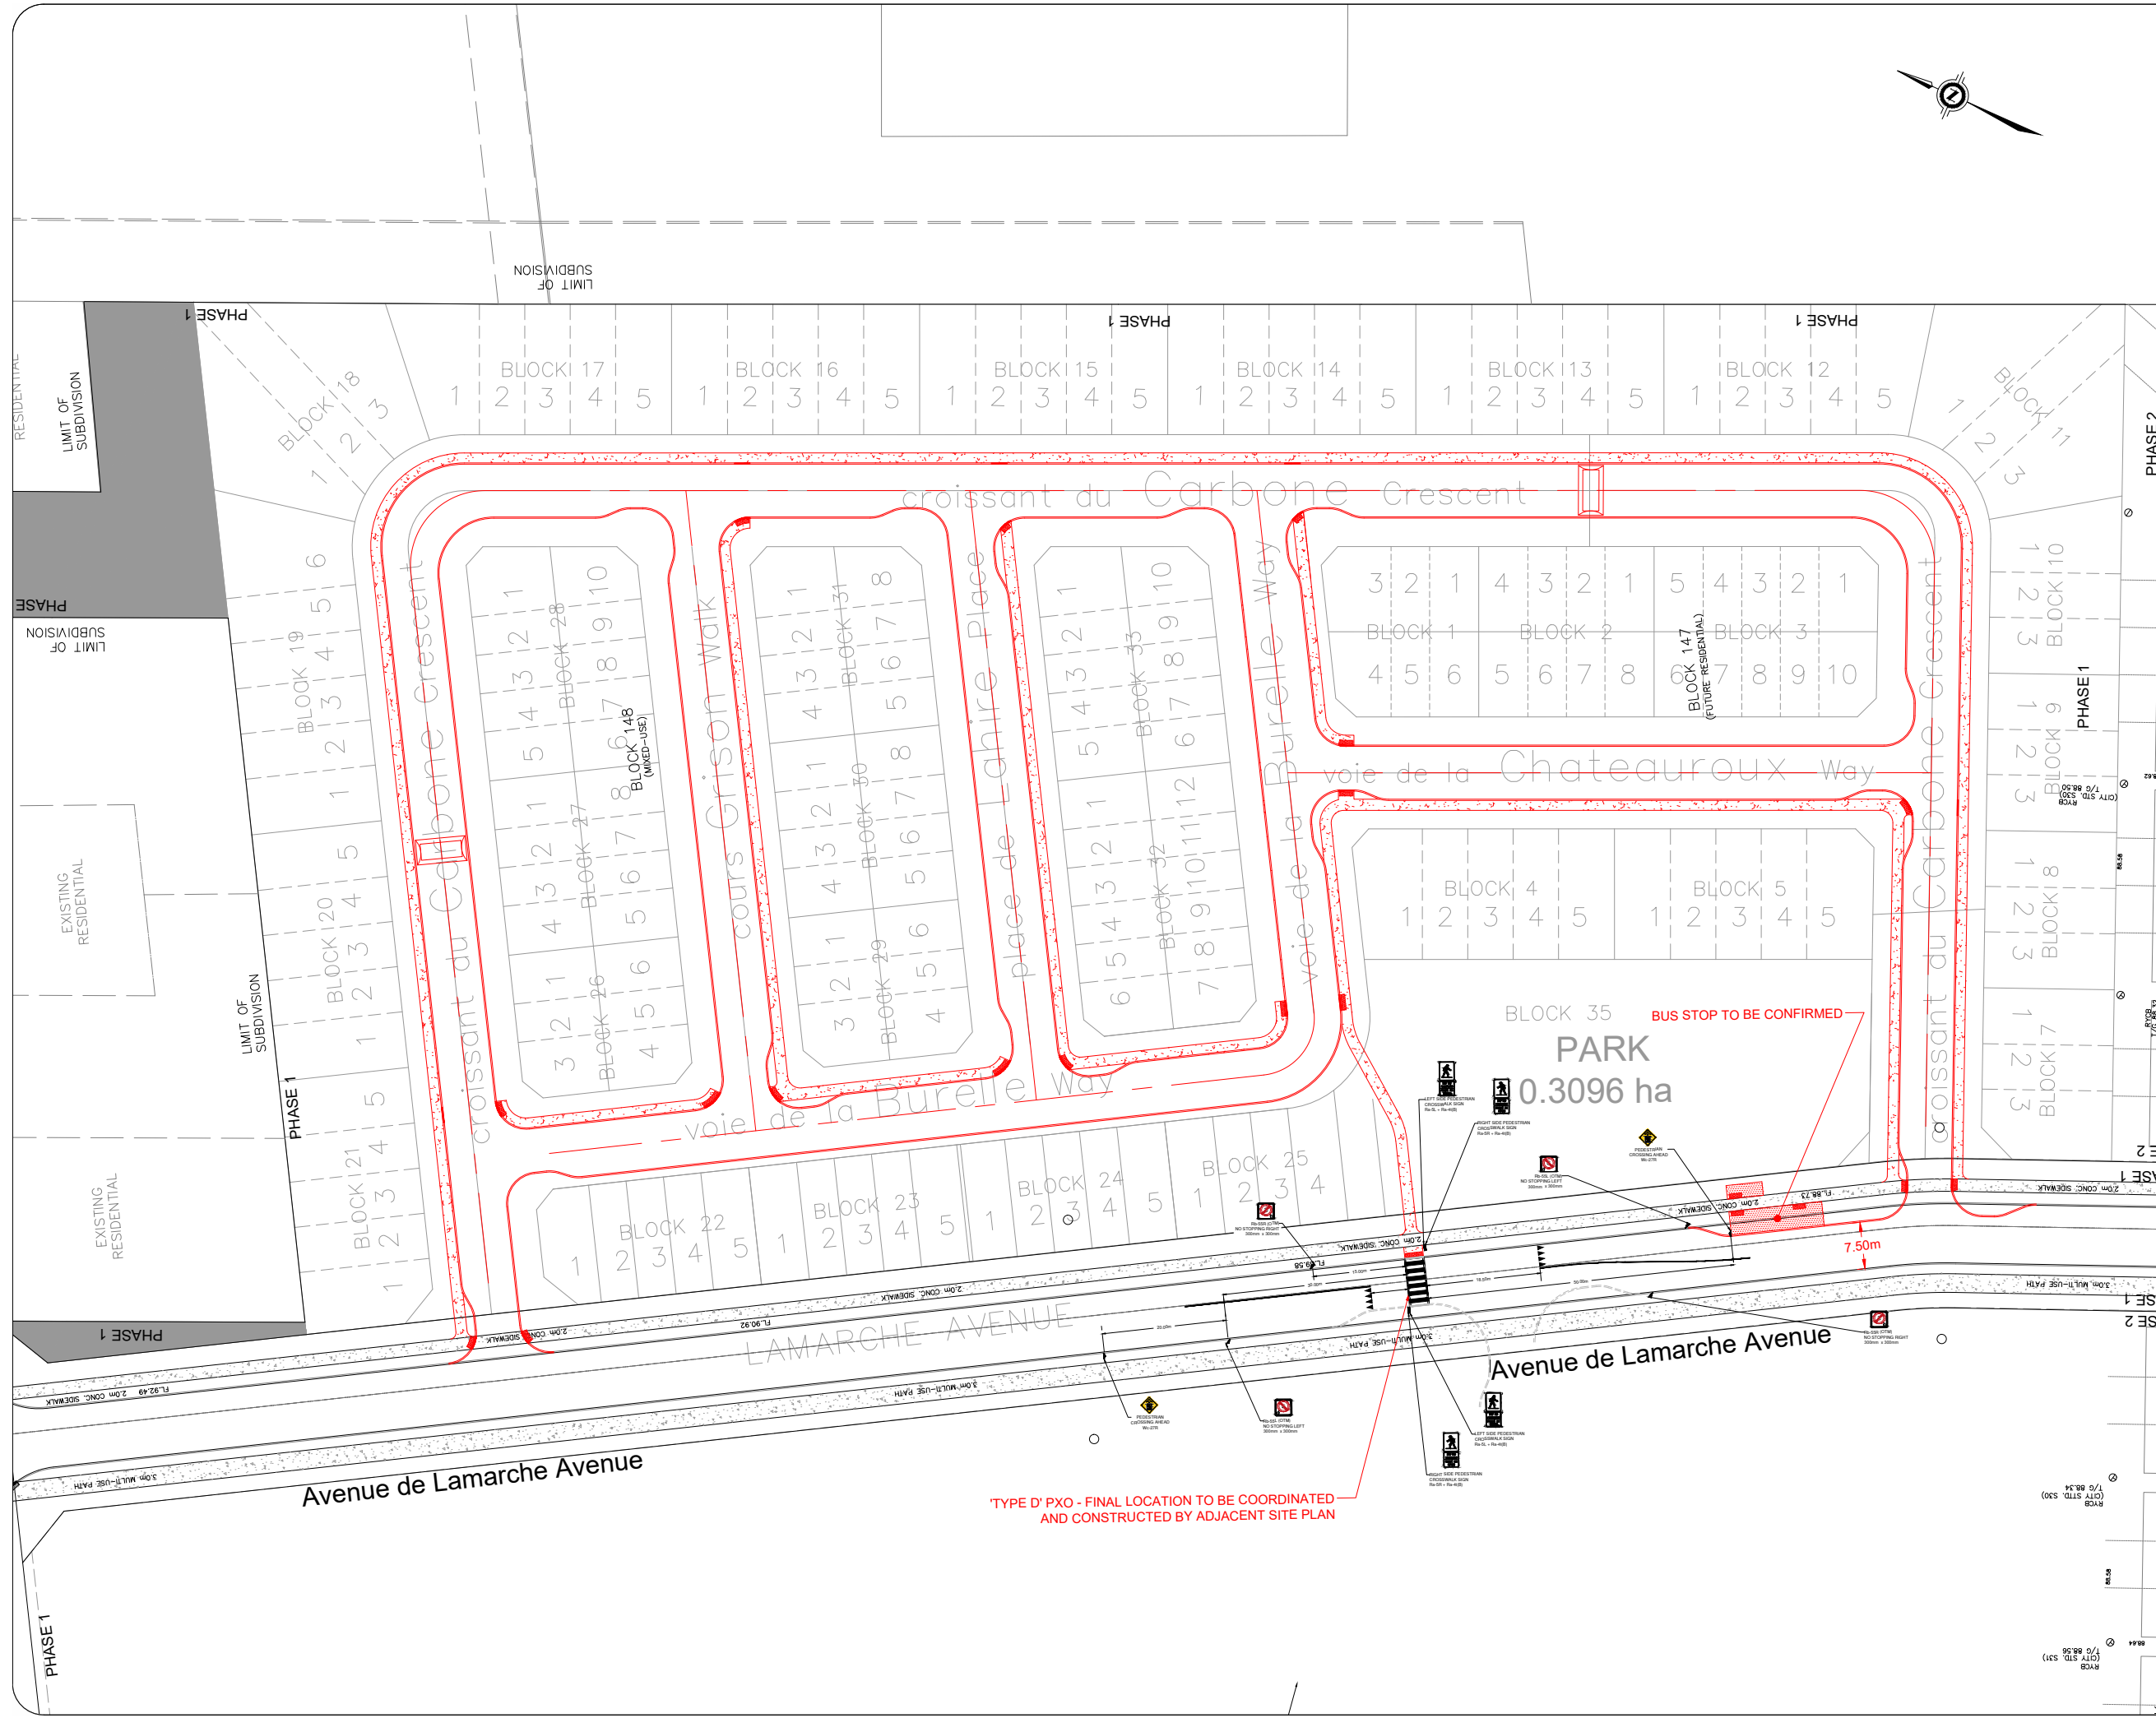

REV:	DESCRIPTION:	BY:	DATE:
05	Updated Site Plan	BB	2023-02-21
04	Updated Site Plan	BB	2022-12-09
03	Updated Site Plan	BB	2022-07-27
02	Updated Site Plan	BB	2022-07-19
01	Issued for Review	BB	2022-04-12

STATUS:



**CGH Transportation**  
6 Plaza Court  
Ottawa, ON  
K2H 7W1  
(343) 999-9117

CLIENT: Caivan (Orleans Village 2) Ltd  
2934 Baseline Road, Suite 302h  
Ottawa, ON  
K2H 1B2

ARCHITECT:

SITE: <b>245-275 Lamarche Ave</b>			
TITLE: <b>Geometric Road Design Redline Concept</b>			
SCALE AT A3: NTS	DATE: 2023-02-21	DRAWN: BB	CHECKED: AL
PROJECT NO: 2022-023	DRAWING NO: 001	REVISION: 05	